

GOVERNMENT CORNER RESTORATION FORM

TOWNSHIP 26S RANGE 5W SEC. 9 PLSS # 400500

FILED  
Date: 1/9/2025 By: JC  
This survey consists of:

DOUGLAS COUNTY OREGON

DATE 1-7-25

Map: \_\_\_\_\_

Narrative: \_\_\_\_\_

Corner Rpt: CS 67/59-40

Corner Designation

sec COR  $\frac{9}{10}$   
 $\frac{16}{15}$

DOUGLAS COUNTY  
SURVEYOR

Monument(s) Found: (Condition and Source)

\_\_\_ Condition report

\_\_\_ Not Found

Renewed

\_\_\_ Unrecorded

\_\_\_ Surveyed In

2 1/2" 1964 DCSD

BRASS CAP 4p 12"

Previous Renewals

Crowder 1951 CS 44/47-5

Godfrey 1964 CS 49/125-25

DCSD 1986 CS 62/31-11

Schulze 2012 M 164-47

Sweeden 2016 M 172-33 A & B

Heimbürger 2019 M 175-18

MONUMENT DETAIL

COUNTY SURVEYORS

OFFICE

T26S R5W

$\frac{59}{516} | \frac{510}{515}$

1964

Accessories Found

Double Trunked 21" W OAK S 48°E 89.0 FT  
TO SCRIBED TRUNK HEATED DOUBLE BLAZE

9" W. OAK North 32.3 FT No BLAZE  
Visible ADD TAG

19" W. OAK N 43 3/4° W 39.9 FT Visible  
SCAR

15" W. OAK S 21°E 46.5 FT Heated  
BLAZE

Monument Set (Procedure and Description)

MONUMENT DETAIL

---



---



New Accessories

---



---



Sketch of Monument, Accessories, and General Area

Location & Comments

---



---




---



---

Comp. Decline. 14 1/2° E  
 Agency DCSO  
 Party Chief S. F. HAUSE  
 Note keeper \_\_\_\_\_  
 Witnesses J. LORSUNG

CS 67/59-40  
 2/4

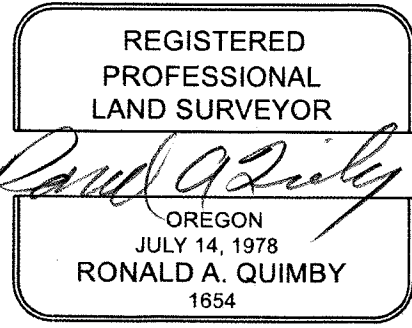

EXPIRES: 12/31/2026

TOWNSHIP 26 RANGE 05 POINT IDENTIFIER # 400500

PRIMARY CORNER DESCRIPTION Sec. Cor. for Secs. 9, 10, 15 & 16

Alias _____	Description _____
Alias _____	Description _____
Alias _____	Description _____
Alias _____	Description _____

Original - Elder & Gile, contract #31 dated April, 1853

-----

Set post cor. to Secs. 9, 10, 15, 16, from which,  
 A W.Oak 18" dia. bears N.88°E., 47 lks.  
 A W.Oak 24" dia. bears S.67½°W., 12 lks.  
 A W.Oak 6" dia. bears N.80°W., 98 lks.  
 A Y.Oak 14" dia. bears S.57½°E., 57 lks.

H.E. Crowder, Party Chief for County Engineers Office  
April, 1951 - C.S. File 44/47-5

-----

Found original BTs in NE and SW quadrants. From these set  
 1" x 48" axle 42" in ground to mark sec. cor. From this,  
 found stump & stump hole corresponding to remaining BTs.  
 Marked trees as follows:  
 8" W.Oak N.46°W., 39.5 ft.  
 24" W.Oak S.63½°W., 14.8 ft.  
 12" W.Oak S.48°E., 89.0 ft.

Milo E. Godfrey, Deputy - Wm. Stoffel; Mike Stone  
January, 1964 - C.S. File 49/125-25

-----

Found - 8" W.Oak now 12" N.46°W., 39.5 ft. opened and  
 found scribing.  
 12" W.Oak now 14" S.48°E., 89.0 ft. scribing  
 visible "T" in not completely healed scar.  
 Orig. BT, W.Oak now 24" N.88°E., 31.0 ft. is still  
 standing.  
 24" W.Oak S.63½°W., 14.8 ft. uprooted & dead, no  
 other BTs found.  
 Did not find axle set in 1951.

Set - Brass cap at cor. mkd. County Surveyors Office, 1964  
 T26S R5W S 9 | S 10  
 S16 | S 15

New BTs - 4" W.Oak north 32.3 ft. mkd. S10 CS BT.  
 8" W.Oak S.33°W., 35.0 ft. mkd. T26S R5W S16 CS BT.  
 Corner lies approx. 90 ft. SE of centerline Wilbur-Glide Road.

Douglas County Surveyors Off. Randall Smith; S. Flause  
February 5, 1986 - C.S. File 62/31-11  
(cont. next page)

MINI GIS  
 43.31596  
 123.28629

CS 62/59-40  
 3/4

TOWNSHIP 26 RANGE 05 POINT IDENTIFIER # 400500

PRIMARY CORNER DESCRIPTION Sec. Cor. 9, 10, 15, 16

Alias _____	Description _____
Alias _____	Description <u>DCRS CAANDANVILLE COTTAGE GROVE COURTS</u>
Alias _____	Description _____
Alias _____	Description <u>175918.854 N</u>
	<u>176568.608 E</u>

Found - A 1964 DCSO brass cap/IP protruding 12" above ground. (Axle from 1951 not found)  
 18" now 24" dia. 3½ ft. high stump with a rotted out center old axe marks & a blaze bears S.81°E., 32.2 ft. (Rec. N.88°E., 31.0 ft. dist. possible face measurements) Orig. BT.  
 No other original BTs found.  
 12" now 16" W.Oak with a fully healed double blaze bears S.48°E., 89.0 ft. (per record)  
 4" now 6" dia. W.Oak with a fully healed double blaze bears North 32.3 ft. (per record)  
 New BTs - 14" dia. W.Oak (was thought to be NW BT per 1951, we opened, no scribing was found) single blazed & scribed "T26S R5W S9 CS BT" bears N.43¾°W., 39.9 ft.  
 4" dia. W.Oak double blazed & scribed "X BT" bears S.21°E., 46.5 ft.  
 Corner lies in a field approx. 90 ft. SE of North Bank Road centerline & 3½ ft. west of a fence.

Fd. BC by M. Schulze, 11/2012 - M164-47

*FND. OK 1-7-25*

Carl Sweeden - For: Tim Clark - Sept. 2016 - M172-33 A&B

Found - 2½" 1964 DCSO brass cap up 12"  
*SCRIBED TRUNK 21" (DOUBLE TRUNKED)* 16" now 19" W.Oak BT, S.48°E., 89.0" healed double blaze with tag ✓ *NO BLZ. VIS.*  
 6" now 9" W.Oak BT, north 32.3', with swell no tag *ADD TAG*  
 19" 14" now 18" W.Oak BT, N.43¾°W., 39.9', scar vis., tag  
 15" 4" now 13" W.Oak BT, S.21°E., 46.5' healed blaze, tag

Fd BC by M Heimburger, 1/2019 - M175-18

*CS 67/59-40  
4/4*