

GOVERNMENT CORNER RESTORATION FORM

FILED

TOWNSHIP 27S RANGE 4W SEC DLC 43 PLSS # 043040

Date: 1/9/2025 By: [Signature]  
This survey consists of:

DOUGLAS COUNTY OREGON

DATE 1-8-25

Map: \_\_\_\_\_  
Narrative: \_\_\_\_\_  
Corner Rpt: LS 67/59-42

Corner Designation

S.E. COR. JACOB JONES DLC #43

DOUGLAS COUNTY  
SURVEYOR

Monument(s) Found: (Condition and Source)

5/8" IRON ROD WITH  
PLASTIC CAP STAMPED  
RE WARE CS 1005

- Condition report
- Not Found
- Renewed
- Unrecorded
- Surveyed In

Previous Renewals

Eppstein 1938 CS 17/2A  
Byron 1951 CS 49/79  
\*Artemus 1990 M 110-4  
WARE 1993 PP 1993-0065 A-B  
Quimby 1999 M 133-52  
WARE 1985 M 99-62 A-B

MONUMENT DETAIL

Accessories Found

5/8" IRON ROD WITH PLASTIC CAP RE  
WARE CS 1005

OAK N71°E 966 FT DID NOT TAG ON  
PRIVATE DRIVE

RENEWAL

Monument Set (Procedure and Description)

MONUMENT DETAIL

---



---



New Accessories

1" Copper Drill Cap "Surv MARK" North  
8.0 FT

1" Copper Drill Cap "Surv MARK" West 8.0 FT

---



---



Sketch of Monument, Accessories, and General Area

Location & Comments

OCRS Coordinates  
Cottage Grove. Canyonville  
Zone

MON 15 IN Center  
OF DARLEY DRIVE  
40 FT WEST OF  
CATTLE GUARD

N 148585.697

E 147817.098

Comp. Decline 14'14" E  
Agency DC60  
Party Chief S. F. HAUSE  
Note keeper  
Witnesses J. LOR SUNG

CS 67/59-42  
2/3

REGISTERED  
PROFESSIONAL  
LAND SURVEYOR

*Ronald A. Quimby*

OREGON  
JULY 14, 1978  
RONALD A. QUIMBY  
1654

EXPIRES: 12/31/2026

TOWNSHIP 27 RANGE 06 POINT IDENTIFIER # 043040

1-8-25

PRIMARY CORNER DESCRIPTION SE Cor. Jacob Jones DLC #43


Alias _____	Description _____
Alias _____	Description _____
Alias _____	Description _____
Alias _____	Description _____

Original - Addison R. Flint, Contract #28 dated April, 1854  
 -----  
 Set stone post in prairie 30 x 8 x 4.  
 Raised mound with trench as per instructions.

H.L. Eppstein, Co. Surv. - Ben F. Jones - For: Harla Moore  
 Aug. 9, 1938 - C.S. File 17/2 A.  
 -----  
 Measured from iron pipes on Laurel Crest Plat and from NE  
 corner of Cl. 43. I set 1" x 30" shaft for corner. I mkd.  
 the following trees:  
     A W.Oak, 30" dia. bears N.71°E., 466 ft. marked S.E.  
     Cl. 43 C.S. B.T.

James W. Byron - Milo E. Godfrey - June 16, 1961 - C.S. 49/79  
 -----  
 Found -  BT as recorded by Eppstein, 1934 (?). 30" W.Oak  
           N.71°E., 466 ft.  
           1" iron shaft at corner & 12" under shoulder of Rd.  
 Set - 3/4" iron rod over shaft & 1" under surface.  
 We find old pipe thus:

DID NOT TAG  
 ON PRIVATE  
 DRIVE

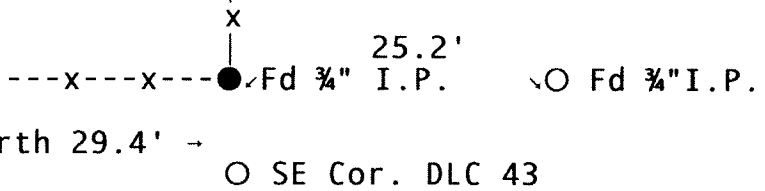

Fd. OK, J. Artman - April, 1990 - M 110 - 4

Romanso E. Ware, Aug. 1993 - For: Romanso E. Ware, Partition  
 Plat 1993-0065 A & B.  
 -----  
 Reset a 5/8" x 30" Iron Rod w/cap stamped 'RE WARE LS 1005'  
 back in position of original D.L.C. corner.

Fd. OK by R. Quimby, Oct. 1999 - M133-52

PER M99-62A - 5/8" IR DUE EAST 35'  
 SET 1" COPPER "SURV MARK" DRILL CAP NORTH, 8'  
 SET 1" COPPER "SURV MARK" DRILL CAP WEST, 8'  
 OCRS, N 148585.697, E 147817.098  
 CORNER FALLS IN THE CENTER OF DARLEY DRIVE  
 40 FT WEST OF CATTLE GAULD.  
 CS 62/59-42  
 3/3