

GOVERNMENT CORNER RESTORATION FORM

FILED

TOWNSHIP 29S RANGE 3W SEC. 34 PLSS # 440100

Date: 1-23-2005 By: KL  
This survey consists of:

DOUGLAS COUNTY OREGON

DATE 1-9-25

Map: \_\_\_\_\_  
Narrative: \_\_\_\_\_  
Corner Rpt: CS 07/59-45

Corner Designation

S 1/4 COR 534 ONLY

DOUGLAS COUNTY  
SURVEYOR

Monument(s) Found: (Condition and Source)

48" D. Fir Corner Tree  
Healed Face N. side DCSO  
BRASS CAP W.C. N130W 4.0 FT

- Condition report
- Not Found
- Renewed
- Unrecorded
- Surveyed In

Previous Renewals

GLD - Bushey 1893 V 16 pg 6953  
DCSO 1962 CS 52/126-94  
BLM Resurvey 1962-1967  
Vol 34 pg 14031-32  
RICE 2004 M 145-76

MONUMENT DETAIL

county surveyors  
T29S R3W  
→ 4 South

1/4 534  
WC  
T30S  
1962 office

Accessories Found

Reference to True Corner  
BRASS CAP Witness Corner N130W  
4.0 FT  
21" D. FIR S160E 18.3 FT Fully Healed  
Low BLAZE Add 3/8" MAG NAIL RIGHT  
Side Center  
33" D. Fir N830E 46.5 FT Fully Healed  
Single BLAZE Add 3/8" MAG NAIL  
RIGHT SIDE CENTER  
Metal Post West Edge of Tree

\_\_\_\_\_  
\_\_\_\_\_  
New Accessories

Reference To W. Corner

N.E Tree N 86 1/2° E 46.0 FT

S.E Tree S 13° E 22.9 FT

New Bearing Trees To W. Corner

16" F. Cedar S 48° W 17.0 FT scribed

"X" CSBT on Double BLAZE 3 1/2" MAG

NAIL Right side center

12" D. Fir N 55° W 26.8 FT scribed 1/4

S34 on Double blaze 3 1/2" MAG NAIL

RIGHT side center

MetN1 Post S 35° W 4.0 FT

Sketch of Monument, Accessories, and General Area

Location & Comments

MON IS APPROX 170 FT  
South of Gravel Road  
on south edge of clearcut  
North edge of older reprod


ORS coordinate system  
Cottage Grove - Canyonville  
zone

\_\_\_\_\_  
\_\_\_\_\_  
\_\_\_\_\_  
\_\_\_\_\_

Comp. Decline. 14 1/4° E  
Agency DCSO  
Party Chief S. F. House  
Note keeper  
Witnesses J. Corning

N 60488.363

E 239683.935

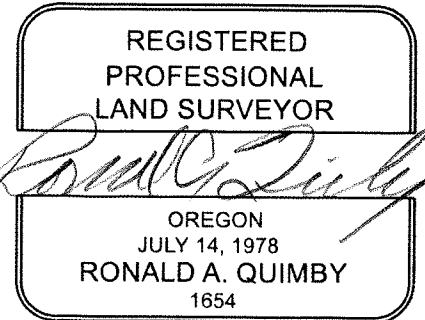

EXPIRES: 12/31/2026

CS 67159-45

213

