

GOVERNMENT CORNER RESTORATION FORM

FILED

TOWNSHIP 30S RANGE 8W SEC. 12

PLSS # 640506 Date: 1/29/2015 By: KL
This survey consists of:

DOUGLAS COUNTY OREGON

DATE 1-27-25

Map: _____

Narrative: _____

Corner Rpt: CS 07159-51

Corner Designation 1/4 COR 512
513

DOUGLAS COUNTY
SURVEYOR

Monument(s) Found: (Condition and Source)

BLM BRASS CAP
UP 6"

Condition report

Not Found

Renewed

Unrecorded

Surveyed In

Previous Renewals

BLM RESURVEY 1963-1964
V 32 PGS 13594-5
BLM RESURVEY 2006
Vol 57 PGS 22544-5

MONUMENT DETAIL

T30S RBW

1/4 512
513

1964

Accessories Found

DECAYED SAWD 30" FIR STUMP S41³/₄° E
160.5 FT
DECAYED SAWD 35" FIR STUMP N18¹/₂° W 19.1 FT
DECAYED Hemlock STUMP S70¹/₂° E 60.1 FT
26" FIR N53° E 231.7 FT HEALED BLAZE
28" FIR S56° E 164.3 FT HEALED BLAZE
13" FIR S3¹/₄° W 19.9 FT
17" FIR N75¹/₂° W 9.3 FT

Monument Set (Procedure and Description)

MONUMENT DETAIL

Horizontal lines for Monument Set description.

New Accessories

Horizontal lines for New Accessories description.


Sketch of Monument, Accessories, and General Area

Location & Comments

WCRS Coordinates
Cottage Grove - Canyonville
Zone

N 49837.123
E 94095.657

Comp. Decline, 14 1/4° E
Agency DCSO
Party Chief S. F. HAUSE
Note keeper
Witnesses J. LORSUNDY

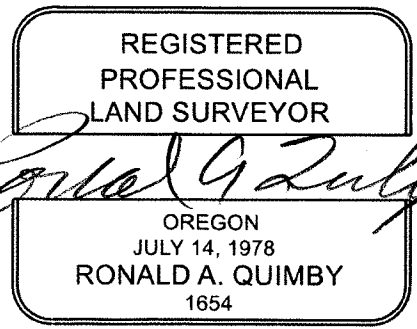

TOWNSHIP 30 RANGE 08 POINT IDENTIFIER # 640500

PRIMARY CORNER DESCRIPTION 1/4 Cors. Secs. 12 & 13

Alias _____	Description _____
Alias _____	Description _____
Alias _____	Description _____
Alias _____	Description _____

GLO survey by W.H. Byars under contract #456, dated July 28, 1882 - (DCSO records Vol. 17 Page(s) 7321-2)

Set a fir post 3 ft. long, 3" sq., 18" in the ground, for 1/4 sec. cor., marked 1/4 S on N side & from which

A fir, 12" dia., bears S.50°E., 25 lks., mkd: 1/4 S BT.

A fir, 14" dia., bears N.5°W., 29 lks., mkd: 1/4 S BT.

BLM dependent resurvey by Donald R. Beck & C. Albert White, Cadastral Surveyor, under group #350 & 548, surveyed May 1963/July 1964 - (DCSO records Vol. 32 Page(s) 13594-5)

The 1/4 sec. cor. of secs. 12 and 13, monumented with an iron rod, 1/2" dia, firmly set, 6" above the ground, from which the remains of the original bearing trees:

A sawed fir stump, 36" dia, bears N.8 1/2°W., 29 lks., with a healed blaze. (Record bearing, N.5°W.)


A sawed fir stump, 33" dia, bears S.41 1/4°E., 25 lks., with scribe mks. visible on opened blaze. (Record bearing, S.50°E.)

and a local bearing tree

A down hemlock, 10" dia, bears S.70 1/2°E., 91 lks., mkd. S13 T30S R8W on opened blaze.

At the corner point

Set an iron post, 28" long, 21" dia, 22" in the ground, with brass cap mkd.

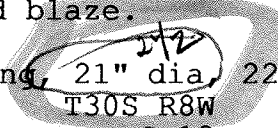
 T30S R8W
 1/4 S 12
 S 13
 1964

from which new bearing trees

A fir, 12" dia., bears N.53°E., 351 lks., mkd. 1/4 S12 BT.

A fir, 7" dia., bears S.56°E., 249 lks., mkd. 1/4 S13 BT.

Reset iron rod alongside the iron post.

BLM Dependent resurvey by A. Bert Skeesick, Cadastral Surveyor under Group No. 2139, surveyed July/Aug. 2006 (DCSO records Vol. 57 Page(s) 22544-5)

The 1/4 sec. cor. of secs 12 and 13, monumented with an iron post, 2 1/2" dia., firmly set, projecting 6" above ground (with an iron rebar, 5/8" dia., projecting 2" above ground alongside), with brass cap (properly) mkd.

from which the remains of the original bearing trees

✓ A decayed, sawed fir stump, 30" dia., bears S.41 1/4°E., 16.5 ft., with no marks visible.

✓ A decayed, sawed fir stump, 35" dia., bears N.8 1/2°W., 19.1 ft., with a healed blaze.

continued next page

CS 07/69-51 pg 3/4

MINI GIS
 42,96975
 123,59468
 23 1/4 MI. EAST END OF MOUNTAIN OLLALA CANYON

FIND OK 1/27/25

TOWNSHIP 30 RANGE 08 POINT IDENTIFIER # 640500

PRIMARY CORNER DESCRIPTION 1/4 Cors. Secs. 12 & 13

Alias _____	Description _____
Alias _____	Description <u>OCRS CANNONVILLE COTTAGE GROVE COORD.S</u>
Alias _____	Description _____
Alias _____	Description <u>49837.123 N</u>
	<u>94095.657 E</u>

and remains of a local BT reported by Beck and White

✓ A decayed hemlock stump, size indeterminate, bears S.70½°E., 60.1 ft., with no marks visible.

and bearing trees mkd. by Beck and White

26" A fir, 22" dia., bears N.53°E., 231.7 ft., with a healed blaze.

28" A fir, 23" dia., bears S.56°E., 164.3 ft., with a healed blaze.

and new bearing trees

13" A fir, 11" dia., bears S.3¼°W., 19.9 ft., mkd. ¼ S13 BT.

17" A fir, 14" dia., bears N.75½°W., 9.8 ft., mkd. ¼ S12 BT.