

TOWNSHIP 31S RANGE 9W SEC. 14

PLSS # 540440 Date: 2/5/2025 By: ICE

This survey consists of:

Map: _____

DOUGLAS COUNTY OREGON

DATE 1-30-25

Narrative: _____

Corner Rpt: CS 6169-S4

Corner Designation

C 1/4 S14

DOUGLAS COUNTY
SURVEYOR

Monument(s) Found: (Condition and Source)

5/8" I. Rod with plastic
Cap marked Hostetter
LS 1975

Condition report

Not Found

Renewed

Unrecorded

Surveyed In

Previous Renewals

Hostetter set per
M 160-4 2009

MONUMENT DETAIL

Accessories Found

10" D. FIR N13°17'E 6.6 FT Fully Healed
Single Blaze

8" I. Cedar S23°21'E 45.1 FT Partially
Healed Single blaze All scribes
Visible

14" D. Fir S5°23'W 66.0 FT Fully Healed
Single Blaze

Note: All distances to Head of
6" Spike in Bottom of Scribed
Face's

Sawn, rotted 21" x 6 1/2" Fir stump N54°59'E 47.5 ft. Face
rotted off 6" Spike nail loose on ground.

Monument Set (Procedure and Description)

MONUMENT DETAIL

Blank lines for Monument Set (Procedure and Description)

New Accessories

Blank lines for New Accessories


Sketch of Monument, Accessories, and General Area

Location & Comments

G. P. S. Position - Hand held
42° 87512° N
123° 73152° N

Mon is on
Moderate N.E
Slope 55' E North
OFF GRAVE ROAD

Comp. Decline. 17 1/2° E
Agency DCSO
Party Chief S. Krause
Note keeper
Witnesses J. LORSON

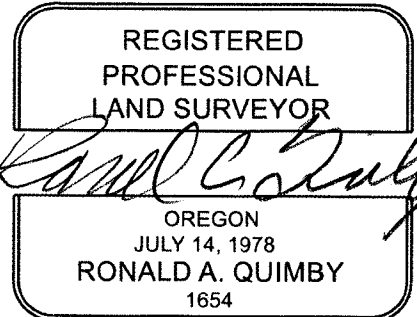

EXPIRES: 12/31/2026

CS 67159-54 pg 2/3

TOWNSHIP 31 RANGE 09 POINT IDENTIFIER # 540440

PRIMARY CORNER DESCRIPTION Center 1/4 Cor. Sec. 14

Alias _____	Description _____
Alias _____	Description <u>GIS POSITION GOOD</u>
Alias _____	Description <u>CHECKED WITH HANDHELD.</u>
Alias _____	Description <u>42.87512 N</u>
	<u>123.73152 W</u>

FWD OK 1/30/25

Tony Hostetter - For: Roseburg Resources Co. & Plum Creek -
Sept. 2009 - M160-4

Set - 5/8"x30"" rebar w/plastic cap marked "HOSTETTER LS
1975" from which:

10" 6"D fir ✓ scribed "S14 1/16 BT", bears; N.13°17'E., 6.6
ft to spike. FHSB

SAWN ROTTED 21" x 6 1/2' STUMP fir ✓ scribed "S14 1/16 BT", bears; N.54°59'E., 47.1
ft to spike. FACE ROTTED OFF 6" SPIKE NAIL LOOSE ON GROUND

8" 8" I cedar ✓ scribed "S14 1/16 BT", bears; S.23°21'E., 5.1
ft to spike. PHSB ALL SCRIBG. VIS.

14" 12"D fir ✓ scribed "S14 1/16 BT", bears; S.5°23'W., 66.0
ft to spike. FHSB

DISTANCES WERE MEASURED TO TOP OF 6" SPIKE NAILS DRIVEN INTO
BOTTOM OF SCRIBED FACES.

MONUMENT IS ON MODERATE NE SLOPE ~ 55 FT. NORTH OF GRAVEL RD.