

TOWNSHIP 315 RANGE 8W SEC. 7 PLSS # 100640

Date: 2-24-2025 By: LC
This survey consists of:

DOUGLAS COUNTY OREGON

DATE 2-11-25

Map: _____
Narrative: _____
Corner Rpt: CS 67/100-5

Corner Designation

1/4 COR S12/S7
R9W R8W

DOUGLAS COUNTY
SURVEYOR

Monument(s) Found: (Condition and Source)

BLM 1962 BRASS CAP

- Condition report
- Not Found
- Renewed
- Unrecorded
- Surveyed In

Previous Renewals

GLD Survey 1900 Vol 19 pg 8242
BLM Resurvey 1960 - 1962
Vol 31 pg 13187
DCSO 1981 CS 61/19-7
DeGroot 2001 M 157-13
Quimby 2016 CS 65/93-61

MONUMENT DETAIL

1/4
S12/S7
R9W R8W
T315
1962

Accessories Found

47" x 2 FT FIR STUMP West 14.2 FT TO bridge
Spike in top
56" x 2 1/2 FT FIR STUMP N180W 32.5 FT
previously opened BLAZE
8" D. FIR S310E 16.5 FT Fully Heated Double
BLAZE ADD 3 1/2" MAG NAIL RIGHT side center
13" x 7 FT SAUN W. FIR STUMP S76W 22.0 FT
Fully Heated Double BLAZE ADD 3 1/2" MAG
NAIL RIGHT side center
6" W. FIR N72W 8.4 FT PARTLY Heated
Single BLAZE All Scribes Visiable Add
3 1/2" MAG NAIL RIGHT side center
9" D. FIR N64E 20.2 FT Rec 19.8 FT PARTLY
Heated single BLAZE Illegible Scribes
Visiable ADD 3 1/2" MAG NAIL RIGHT
side center

Monument Set (Procedure and Description)

MONUMENT DETAIL

Horizontal lines for Monument Set description.

New Accessories

Horizontal lines for New Accessories description.

Sketch of Monument, Accessories, and General Area

Location & Comments


Trimble Geo XT uncorrected
Lat - Long
43° 53' 22.59" N
123° 42' 07.02" W

mon on moderate
NW slope JUST
North of large
Bench SW quadrant
clearcut, rest old
growth

Comp. Decline. 14 1/2° E
Agency DCSO
Party Chief S K Huse
Note keeper
Witnesses J. Lorusso

CS 67/60-5

pg 2/4

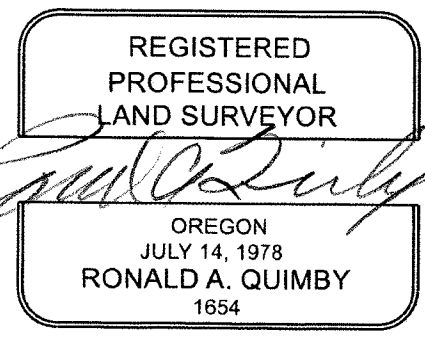

EXPIRES: 12/31/2026

PRIMARY CORNER DESCRIPTION 1/4 Cor. for Sec. 7; and 12, T31-9

Alias _____	Description _____
Alias _____	Description _____
Alias _____	Description _____
Alias _____	Description _____

MINI GIS
42.88957
123.70193

GLO survey by W.H. Byars, Deputy Surveyor under contract # 456 dated July 28, 1882 (DCSO records Vol. 19 Page(s) 8107)

Set a Cedar post 3 ft. long, 3" sq., 20" in the ground, mkd. 1/4 S for the 1/4 sec.cor., and from which

A Fir 48" dia., bears S.44°E., 26 lks. dist. mkd. 1/4 S BT

A Fir 42" dia., bears West, 20 lks. dist. mkd. 1/4 S BT.

GLO survey by Wm. H. Byars, Deputy Surveyor, under Contract #727, dated Dec. 20, 1900 - (DCSO records Vol. 19 Page(s) 8242)

Post gone. Witness trees standing and agree with notes furnished by the Surveyor General. Set a Fir post 4 ft. long, 4" sq., 24" in the ground mkd. S7 on E. and S12 1/4 S on W. faces, for the 1/4 sec. corner. Point established from the witness trees.

BLM Resurvey by C. Albert White, Harold D. Corbin, Cadastral Surveyors and Donald R. Beck, Surveying Technician, Under Group #446, Surveyed Nov. 1960/Sept. 1962 - (DCSO records Vol. 31 Page(s) 13187)

The 1/4 sec. cor., determined at record brg. and dist. from the original bearing trees:

A Fir 56" dia., bears S.44°E., 26 lks. dist., mkd. with visible bark scribing 1/4 and cruiser marks.

A Fir 47" dia., bears West, 20 lks. dist. mkd. with a healed blaze.

At the corner point

Set an iron post, 28" long, 2 1/2" dia., 22" in the ground, with brass cap mkd:

S 12	1/4	S 7
R 9 W		R 8 W
	T 31 S	
	1962	

from which new bearing trees:

A Fir 12" dia., bears N.63 1/2°E., 54 lks. dist., mkd. 1/4 S7 BT.

A Fir 55" dia., bears N.80°W., 50 lks. dist., mkd. 1/4 S12 BT on bark blaze.

Douglas Co. Surveyors Office - Greg Quibell, Deputy - Debbie Stewart, crew - Feb. 19, 1981 - C.S. File 61/19-7

Found - 1962 BLM brass cap in good condition, buried in the ground approx. 8", properly stamped.

(Cont. Next Page)

PRIMARY CORNER DESCRIPTION 1/4 cor. for sec. 7; and 12, T31-9

Alias _____	Description _____
Alias _____	Description <u>TRIMBLE GEO XT UNCORRECTED</u>
Alias _____	Description _____
Alias _____	Description <u>42° 53' 22.591" N</u>
	<u>123° 42' 07.021" W</u>

Stump of orig. 42" now 47" Fir with BLM BT tag, bears West, 13.2 ft. to the face.
 Stump of orig. 48" Fir (sec. 7) which has rolled over and slid down hill almost on top of the cap.
 New Accessories:
 Set boat spike in top of orig. sec. 12 BT stump which is now 47". Spike bears West, 14.5 ft.
 Set boat spike in top of 48" Fir stump which bears N.38°E., 66.9 ft.
 Both stumps have new BT tags. No trees suitable for scribing are in the vicinity.

DECLINATION 14 1/2° E RENEWED 2/11/25

Kris DeGroot - For: Roseburg Resources - 6/2001 - M 137-13

Found - 2 1/2" iron post, USBLM in 1962, firmly set flush w/ground w/3/4" USBLM brass cap properly mkd.

From which OBTs by Byars in 1882:

NOT SEEN A root hole bears S.44°E., 17.2 ft. w/uprooted 56" D.Fir stump lying on the North edge of the BCIP.

2 FT. TALL 47" Fir stump bears West 13.2 ft to face, 14.2 ft to bridge spike (1981 rec 14.5 ft to bridge spike)

BT by White & Corbin in 1962

2 1/2 FT. TALL 56" Fir stump bears N.80°W., 32.5 ft. no scribing visible (Rec. 50 lks.) PREVIOUSLY OPENED BLAZE

BT by Quibell, DCSO in 1981

NOT CHKD. 48" Fir stump which bears N.38°E., 66.9 ft. to a boat spike.

New BTs 8" 6" D.Fir bears S.31°E., 16.5 ft. scribed "1/4 S7 BT" FHDB

13" x 7" FT. SAWN STAMP 9" W.Fir bears S.76°W., 22.0 ft. scribed "1/4 S12 BT" FHDB

Note- All new BTs have double blazed faces w/brass washer stamped "PLS 1941" nail into the lower blaze. Bearings are taken to the center of the tree at the root crown & distances are measured to a nail in the root crown at the center of the tree all BTs have a 6" red band painted around the tree & the blazed face painted red & BT signs nailed to the tree.

ALL WASHERS AND NAILS NOW INSIDE TREES ADD 3 1/2" MAG NAIL R.S.C. TO THESE 2 BT.S

Ron Quimby - 12/2/2016 - C.S. File 65/93-61

Found - BLM brass cap

New - 6" BTs per M137-13

A 6" D.Fir N.72°W., 8.4 ft. scribed 1/4 S12 BT. PHSB ALL SCR BG VIS.

A 8" D.Fir N.64°E., 19.8 ft. scribed 1/4 S7 BT. PHSB ILLEG. SCR BG.

202

MONUMENT ON MODERATE NNW SLOPE
 JUST NORTH OF LARGE BENCH
 SW QUADRANT CLEARCUT, REST OLD REGROWTH

ADD 3 1/2" MAG NAIL R.S.C. TO THESE 2 BT.S