

TOWNSHIP 315 RANGE 9W SEC. 23 PLSS # 400300

Date: 2-24-2025 By: IC

This survey consists of:

Map: \_\_\_\_\_

Narrative: \_\_\_\_\_

Corner Rpt: CS 67160-6

DOUGLAS COUNTY OREGON

DATE 2-13-25

DOUGLAS COUNTY  
SURVEYOR

Corner Designation

Sec Cor 23 | 24  
26 | 25

Monument(s) Found: (Condition and Source)

\_\_\_ Condition report

\_\_\_ Not Found

Renewed

\_\_\_ Unrecorded

\_\_\_ Surveyed In

DCSO BRASS CAP  
Proj 10"

Previous Renewals

DCSO 1967 CS 54/32-95

MONUMENT DETAIL

DOUGLAS COUNTY  
SURVEYORS OFFICE

T 315 R 9 W

523 | 524

526 | 525

1967

Accessories Found

5" X 4 FT D. FIRE STAB N138°E 38.3 FT  
Illegible Scribes Visible  
25" X 6 1/2 FT SAWN FIR STUMP S46°W  
39.6 FT Fully Healed Single BLAZE  
21" D. FIRE N17 1/2° W 20.9 FT (Rec 21.2 FT)  
Fully Healed Double BLAZE ADD 3 1/2" MAG  
NAIL RIGHT Side Center  
9" Chinquapiñ N17°E 21.8 FT (Rec 21.4 FT)  
3 1/2" MAG NAIL RIGHT Side Center ADDED  
UNRECORDED 12" D. FIRE N66°E 25.1 FT  
Partly Healed Double BLAZE Pitched over  
Scribing Tree has 6" spike RIGHT Side  
Center

Monument Set (Procedure and Description)

MONUMENT DETAIL

Blank lines for Monument Set description.

New Accessories

Blank lines for New Accessories description.

Sketch of Monument, Accessories, and General Area

Location & Comments

OCRS COORDINATES  
Cottage Grove - Canyonville  
Zone


MON. ON Gentle  
E NE Slope in  
older Reprod  
100 ± FEET EAST  
OF GRAVEL ROAD

N 7606.837  
E 59872.996

Comp. Decline. 14 1/2° E  
Agency DCGO  
Party Chief S FINN  
Note keeper  
Witnesses J. Loring

CS 67160-6

pg 2/3

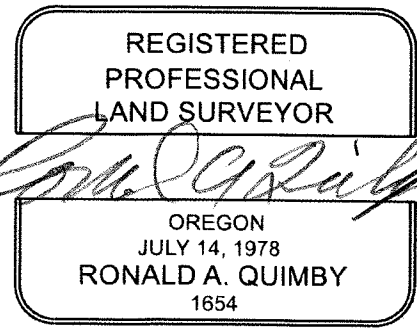

EXPIRES: 12/31/2026

TOWNSHIP 31 RANGE 09 POINT IDENTIFIER # 600300

PRIMARY CORNER DESCRIPTION Cor. Secs. 23, 24, 25, & 26

Alias \_\_\_\_\_ Description \_\_\_\_\_  
 Alias \_\_\_\_\_ Description CCRS CAMPVILLE COTTAGE GROVE COORD.S  
 Alias \_\_\_\_\_ Description \_\_\_\_\_  
 Alias \_\_\_\_\_ Description 7608.837 N  
59872.990 E

GLO survey by W.H. Byars under contract #727, dated December 20, 1900 - (DCSO records Vol. 19 Page(s) 8183)

Set a fir post, 4 ft. long, 4" sq., 24" in the ground for cor. to secs. 23, 24, 25, & 26, marked T31S S 24 on NE, R9W S 25 on SE, S 26 on SW, S 23 on NW faces, also 2 notches on S & 1 notch on E angles; from which

- A fir, 16" dia. bears N.35°E. 58 lks. mkd: T31S R9W S24 BT
- A fir, 18" dia. bears S.60°E. 67 lks. mkd: T31S R9W S25 BT
- A fir, 10" dia. bears S.46°W. 60 lks. mkd: T31S R9W S26 BT
- A fir, 10" dia. bears N.25°W. 25 lks. mkd: T31S R9W S23 BT

Douglas Co. Surveyors Office - John M. Powell - Frank Jones & E. West - Feb. 1967 - C.S. File 54/32-95

*RENEWED 2/13/25*

Found 5" x 4 FT. Orig. 16" D. Fir, now Stob, N.38°E. 38.3 ft., scribe visible. *ILLEGIBLE*

*LOST TO SKID RD.* Orig. 18" D. Fir, now 24" D. Fir, S.60°E., 44.2 ft., shows good scar.

*SAWN STUMP 25" x 6 1/2 FT.* Orig. 10" D. Fir, now 18" D. Fir, S.46°W., 39.6 ft., shows good scar. *FHSB*

*ROTTED TO GROUND NO GOOD EVID.* Orig. 10" D. Fir, now stump, N.25°W., 16.5 ft.

Set Brass Cap at Cor. mkd: County Surveyors Office 1967 T31S R9W S 23 | S 24 | S 26 | S 25

*PROT. 10"*

New BTs 2 1/8" D. Fir N.17 1/2°W., 21.2 ft. mkd. T31S R9W S23 CS BT. *FHDB*  
9" Chinquapin N.17°E. 21.4 ft mkd T31S R9W S24 CS BT. *FHDB*

*218 ADD 3 1/2" MAG NAIL RSC TO THESE 2 B.T.'S*

*UNRECORDED 12" D. FIR PARTIALLY HEALED DOUBLE BLAZE PITCHED OVER N66°E 25' MONUMENT ON GENTLE ENE SLOPE IN OLDER REPROD. ≈ 100 FT EAST FROM GRAVEL RD. SCRIBING TREE HAS 6" SPIKE R.S.C.*

*12.85343  
123.72172*