

TOWNSHIP 315 RANGE 9W SEC. 26

PLSS # 560246 Date: 2-24-2025 By: LC  
This survey consists of:

DOUGLAS COUNTY OREGON

DATE 2-18-25

Map: \_\_\_\_\_

Narrative: \_\_\_\_\_

Corner Rpt: CS 67/60-7

Corner Designation

1/4 COR 527/526

DOUGLAS COUNTY  
SURVEYOR

Monument(s) Found: (Condition and Source)

DCSO 1967 BRASS CAP  
projecting 11"

\_\_\_ Condition report

\_\_\_ Not Found

\_\_\_ Renewed

\_\_\_ Unrecorded

\_\_\_ Surveyed In

Previous Renewals

DCSO 1967 CS 54/32

MONUMENT DETAIL

COUNTY SURVEYORS

OFFICE

1/4

527/526

1967

Accessories Found

FIR Rotted TO Ground S85°E 28.4 FT

Very Rotted 12" OAK S75°W 16.5 FT

16' x 5 FT SPWN D. FIR stump S81 1/2°E

35.3 FT Fully Heated Double BLAZE ADD

3 1/2" MAG NAIL RIGHT Side Center

27" D. FIR S47 1/4°W 11.7 FT (REC 12.2 FT)

Fully Heated Single BLAZE ADD

3 1/2" MAG NAIL RIGHT Side Center

New Accessories

UNRECORDED BEARING TREES SCRIBED  
 BY LS 86454 12-23 (STEPHAN STYS)  
 15" D. FIR N 41°W 15.8 FT SCRIBED  
 E 1/4 S27 BT WITH UNHEATED SINGLE BLAZE  
 11" D. FIR N 72°W 16 FT SCRIBED E 1/4 S27 BT  
 WITH UNHEATED SINGLE BLAZE  
 23" D. FIR S 3°W 34.3 FT SCRIBED E 1/4 S27 BT  
 WITH UNHEATED SINGLE BLAZE  
 THESE TREES HAVE 4" SPIKES LEFT  
 SIDE CENTER HAVE HIGH BARK BLAZE  
 "X" WITH BLAZES PAINTED ORANGE

Sketch of Monument, Accessories, and General Area


Location & Comments

OGRS COORDINATE SYSTEM  
 COTTAGE GROVE - CANYONVILLE  
 ZONE

MON ON MODERATE  
 SOUTH SLOPE  
 70 FT ± SOUTH OF  
 GRAVEL ROAD  
 OLDER CLEARCUT TO  
 EAST OLD REGROWTH  
 TO WEST  
 Comp. Decline. 14 1/2° E  
 Agency DLSO  
 Party Chief S. FINNISE  
 Note keeper  
 Witnesses J. LORSUNG

N 5028.671  
 E 54634.154

CS 67/60-7 pg 2/3

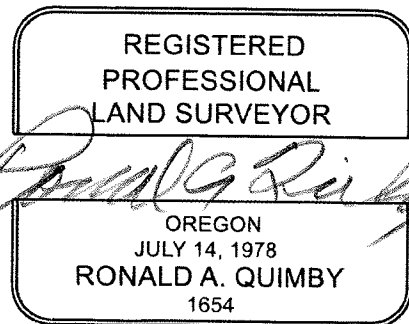

EXPIRES: 12/31/2026

PRIMARY CORNER DESCRIPTION 1/4 Cor. Secs. 26 & 27

Alias _____	Description _____
Alias _____	Description <u>DCRS CANYONVILLE COTTAGE GROVE COORD.S</u>
Alias _____	Description _____
Alias _____	Description <u>5028.671 N</u>
	<u>54634.154 E</u>

MINI GIS  
42.84624  
123.74146

GLO survey by W.H. Byars under contract #727, dated December 20, 1900 - (DCSO records Vol. 19 Page(s) 8193)

Set a Fir post, 4 ft. long, 4" sq., 24" in the ground, marked S26 on E and S27 1/4 S on W faces for 1/4 sec. cor. from which  
A fir, 10" dia., bears S.85°E., 43 lks., mkd: S26 1/4 S BT.  
An Oak, 12" dia., bears S.75°W., 25 lks. mkd: S 27 1/4 S BT.

DECLINATION 14 1/2° E

RENEWED 2/18/25

Douglas Co. Surveyors Office - John M. Powell - Frank Jones, & J. Brady - March 1967 - C.S. File 54/32

Found ~~10" D. Fir, now stump~~, S.85°E. 28.4 ft., opened for scribe ~~"B" GONE~~

ROTTED TO GROUND

VERY ROTTED 12" Oak S.75°W. 16.5 ft., this tree down & burnt.

Set - Brass Cap at Cor. Mkd: County Surveyors T31S R9W, Office, 1967 1/4 S 27 | S 26

PROT 11"

New BTs 16" X 5 FT SAWN STUMP 11" D. Fir S.81 1/2° E. 35 ft. mkd. 1/4 S26 CS BT. FHDB

27" 8" D. Fir S.47 1/2° W. 12 ft mkd. 1/4 S27 CS BT. FHSB

112

ADD 3/8 MAG NAIL R.S.C.

NEW UNRECORDED REFS LS 86454 (12-23)

15" D. FIR SCRIBED "E" 1/4 S27 BT "UNHEALED SING. BLZ. N41° W, 15 8 FT.

6" STEEL SPIKE L.S.C.

11" D. FIR " " " " " N72° W, 16 9 FT

6" STEEL SPIKE L.S.C.

23" D. FIR " " " " " S03° W, 34 3 FT.

6" STEEL SPIKE L.S.C.

ALL NEW TREES HAVE HIGH BARK BLAZE "X"

ALL NEW TREES HAVE ORANGE PAINT ON BLAZING.

MONUMENT ON MODERATE SOUTH SLOPE ≈ 70 FT SOUTH OF GRAVEL RD.  
OLDER CLEARCUT TO EAST OLD REGROWTH TO WEST.