

TOWNSHIP 315 RANGE 6W SEC. 22

PLSS # 50346

Date: 3/26/25 By: KC
This survey consists of:

DOUGLAS COUNTY OREGON

DATE 3-19-25

Map: _____
Narrative: _____
Corner Rpt: CS 67/60-8

Corner Designation

1/4 COR 22/23

DOUGLAS COUNTY
SURVEYOR

Monument(s) Found: (Condition and Source)

3 1/4" BLM BRASS CAP

- Condition report
- Not Found
- Renewed
- Unrecorded
- Surveyed In

Previous Renewals

BLM Resurvey 1980-1981

Vol 45 pg 17293-94

Lang 1995 M 125-3

DCSO 1996 CS 64/69-14

MONUMENT DETAIL

T 315 RW
1/4
S22 S23
1980

Accessories Found

18" D. FIR S88°E 26.0 FT (Rec 25.7)

Fully Heated Single BLAZE

13" D. FIR N55 1/4 W 43.0 FT (Rec 43.5)

Fully Heated Single BLAZE

11" D. FIR N6 1/2°E 5.2 FT Fully Heated

Double BLAZE

14" D. FIR S23 1/2°W 9.5 FT Fully Heated

Double BLAZE

Add 3 1/2" WHG NAILS RIGHT Side Center
To All Bearing Trees

Monument Set (Procedure and Description)

MONUMENT DETAIL

New Accessories

Sketch of Monument, Accessories, and General Area

Location & Comments

OCRS COORDINATE SYSTEM
Cottage Grove - Canyonville
Zone


MON IS APPROX.
70 FT EAST OF
GROVE ROAD

N 449169.706
E 4147338.812

Comp. Decline. 14 1/2° E
Agency DCSO
Party Chief S. K. HOUSE
Note keeper
Witnesses J. LORSUNG

CS 67/60-8

pg 2/3

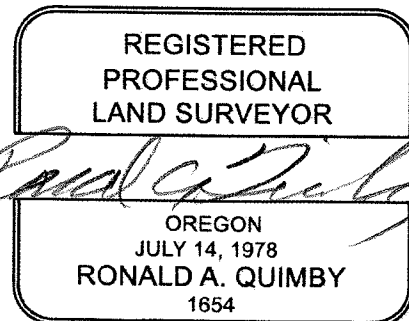

EXPIRES: 12/31/2026

TOWNSHIP 31 RANGE 06 POINT IDENTIFIER # 500340

PRIMARY CORNER DESCRIPTION 1/4 Cor. for Secs. 22 and 23

Alias _____	Description _____
Alias _____	Description <u>DCRS CANYONVILLE COTTAGE GROVE COORDS</u>
Alias _____	Description _____
Alias _____	Description <u>449164.706 N</u>
	<u>4147338.812 E</u>

MINI GIS
42.86249
123.36733

Original - W.H. Byars, under contract # 448 survey dated June 13, 1882 (DCSO records Vol. 19 Page(s) 7973-74)

Set Fir post 3 ft. long, 3" sq., 18" in the ground for 1/4 sec. cor. mkd. 1/4 S on W. face, from which
A Laurel 8" dia., bears S.58°W., 4 lks. dist., mkd. 1/4 S BT
A Fir 28" dia., bears S.60°E., 29 lks. dist., mkd. 1/4 S BT.

BLM resurvey by James E. Jelley and Wayne L. Rogers, under Group #1042, surveyed Oct. 1980/Oct. 1981 (DCSO records Vol. 45 Page(s) 17293-94)

Point for the 1/4 sec. cor. of secs. 22 and 23, at proportionate distance; there is no remaining evidence of the original corner.

Set an iron post, 28 ins. long, 2 1/2 ins. dia., 24 ins. in the ground, with brass cap marked
T 31 S R 6 W
1/4
S 22 S 23
1980

from which
A Fir 6" dia., bears S.88°E., 40 lks. dist. mkd. 1/4 S23 BT.
A Fir 10" dia., bears N.55 1/2°W., 67 lks. dist. mkd. 1/4 S22 BT.

From this point, United States Geological Survey triangulation station SILVER BUTTE Reference Mark No. 2, bears S.62°25'E., 41.41 chs. dist., monumented with a brass cap, 3" dia., set in a concrete footing, 3 x 3 x 3 ft. sq. at the southwest corner of lookout tower, with brass cap mkd. SILVER BUTTE No 2 1942 with an arrow pointing to the corner. The triangulation station has been removed or destroyed.

Found OK by Lang, April 1995 - M125-3

Douglas County Surveyors Office - Randall Smith & Stephen Flause - C.S. 64/69-14 - July 15, 1996

Mon. Fd.- 3 1/4" Dia. Brass cap on a 2 1/2" o.d. iron pipe protrudes 5" above ground.

Bt's Fd.- 18" dia. D.Fir with a fully healed single blaze bears S.88°E., 25.7 260

13" dia. D.Fir with a fully healed single blaze bears N.55 1/2°W., 43.5 430

New Bt's- 11" dia. D.Fir double blazed and scribed "1/4 S23 CS BT", bears N.6 1/2°E., 5.2' FHDB

14" dia. D.Fir double blazed and scribed "1/4 S22 CS BT", bears S.38 1/2°W., 9.5' FHDB

DECLINATION 14 1/2°E MONUMENT IS 20 FT EAST FROM GRAVEL RD.

CS 67160-8 pg 313

3/19/25
ADD 3 1/2" MAG NAIL R.S.C.
MARKED AS ABOVE TO FOUND B.T.'S