

TOWNSHIP 3/5 RANGE 5W SEC. 5

PLSS # 200600

Date: 3/26/25 By: KE  
This survey consists of:

DOUGLAS COUNTY OREGON

DATE 3-19-25

Map: \_\_\_\_\_

Narrative: \_\_\_\_\_

Corner Rpt: CS 67160-9

Corner Designation

DOUGLAS COUNTY  
SURVEYOR

sec cor  $\frac{6}{7} \frac{5}{8}$

Monument(s) Found: (Condition and Source)

Condition report

Not Found

Renewed

Unrecorded

Surveyed In

ORIG. CORNER TREE 34"

FIR SWAG 3 1/8" BRASS

CAP REFERENCE MONUMENT

Previous Renewals

BLM RESURVEY 1966-1968

Vol 35 pg 14378-79

DCSO 1975 CS 57/39-35

BLM RESURVEY 1998 Vol 53

pg 20981

Quimby 2016 M 171-12A&B

MONUMENT DETAIL

Accessories Found

23" D. FIR N130°E 2.0 FT (REC 3 LKS)

Healed BLAZE

28" P. PINE S72 1/4°E 14.5 FT (REC 22 LKS)

Healed BLAZE

30" X 2 FT ROTTED BROKEN CEDAR STUMP S22°E

30.4 FT (REC 46 LKS) NO MARKS ON OPEN BLAZE

19" X 9 FT FIR SWAG N110°W 2.7 FT (REC 4 LKS)

with Healed BLAZE

20" I. CEDAR N54°E 46.2 FT (REC 70 LKS)

VIS. SCRIBES ON PARTLY HEALED BLAZE

"R 5" B

23" D. FIR N15 1/4°W 52.8 FT (REC 80 LKS) Healed

Double BLAZE

3 1/8" BRASS CAP PROJ 3" S46°E 3.7 FT (REC

5.6 LKS) MARKED RM 3.7 FT TO COR 1998

ARROW POINTING TO CORNER

Monument Set (Procedure and Description)

MONUMENT DETAIL

Blank lines for Monument Set description.

New Accessories

Blank lines for New Accessories description.

Sketch of Monument, Accessories, and General Area

Location & Comments

OCRS Coordinate System  
Cottage Grove - Canyonville  
zone

Mon. is approx 30  
feet north of  
Gravel Road


N 461712.771

E 4163351.519

Comp. Decline. 1 1/2° E  
Agency DCBO  
Party Chief S. F. HAUSE  
Note keeper  
Witnesses J. LORSUNG

CS 67140-9

pg 2/4

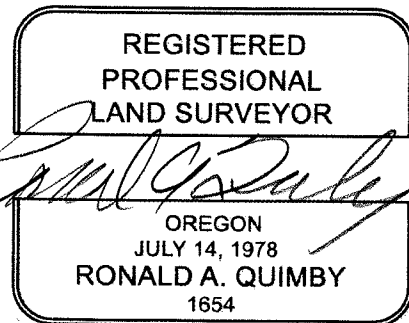

EXPIRES: 12/31/2026

TOWNSHIP 31 RANGE 05 POINT IDENTIFIER # 200600

PRIMARY CORNER DESCRIPTION Corner to Sections 5, 6, 7, & 8.

Alias _____	Description _____
Alias _____	Description _____
Alias _____	Description _____
Alias _____	Description _____

MIN 6/5  
42.89840  
123.32919

Original - George W. Hyde under Contract #54 dated Feb. 19, 1855 (DCSO records, Vol. 19 Page 7886)

-----

Marked a Fir, 18" dia. for corner, from which:

- A Fir, 12" dia. bears N.10°W., 4 lks. dist.
- A Fir, 10" dia. bears N.30°E., 3 lks. dist.
- A Bull Pine, 14" dia. bears S.75°E., 22 lks. dist.
- A W.Cedar. 30 x 30" dia. bears S.22°E., 46 lks. dist.

B.L.M. Resurvey - John M. Jelley, Lynn M Roseberry, Floyd A Brooks, under Group #s 320 & 614, surveyed, June 1966 through May 1968. (DCSO records Vol. 35, Pg.14378-79)

Found - Original corner tree, a Fir, 33" dia. with a healed blaze on the SE and SW face, from which the original bearing trees:

- A Fir, 20" dia. bears N.30°E., 3 lks. dist., with a healed blaze.
- A Pine, 26" dia. bears S.75°E., 24 lks. dist., with a healed blaze. (rec. 22 lks.)
- A Cedar, 38" dia. bears S.22°E., 46 lks. dist., with fragmentary scribe marks visible on open blaze.
- A Fir, 19" dia. bears N.10°W., 4 lks. dist., with a healed blaze.

New Accessories -

- A Madrone, 21" dia. bears S.51°W., 60 lks. dist. marked: T31S R5W S7 BT.
- An iron post, 28" long, 2½" dia. set 24" in ground for reference monument, bears S.30°E., 5 lks. dist., with brass cap marked: T31S R5W S8 RM 1966 and an arrow pointing to the corner.

Douglas Co. Surveyors Office - Gary L. Langlitz, Clrell E. Goodwin, A. Vic Cangie, M.Lenora Ladig. C.S. File 57/39-35 Dec. 16, 1975.

Found - Orig. 18" now 33" corner tree with healed blazes on SE and SW faces from which original bearing trees are located as follows:

- 12" now 19" D.Fir alive and well healed blaze bears N.10°W., 2.6 ft. (orig.)
- 10" now 21" D.Fir, alive and well healed, bears N.30°E., 2.0 ft. (orig.)
- 14" now 26" P.Pine, alive and well healed bears S.75°E., 15.8 ft. (orig.)
- 30" I.Cedar, now a 40" stump with scribe marks visible on opened blaze, bears S.22°E., 30.4 ft. (orig.)

(Cont. Next Page)

CS 07160-9 pg 34

TOWNSHIP 31 RANGE 05 POINT IDENTIFIER # 200600

PRIMARY CORNER DESCRIPTION Corner to Sections 5, 6, 7, 8

Alias _____	Description _____
Alias _____	Description <u>OCCRS CANYONVILLE COTTAGE GROVE GODDARD</u>
Alias _____	Description _____
Alias _____	Description <u>461712.771 N</u>
	<u>4163351.519 E</u>

Found - (cont.)

A 2½" dia. iron pipe firmly set with brass cap attached properly marked (A BLM 1966 Brass cap) bears S.30°E., 3.3 ft.

A Madrone BT also marked in 1966 by BLM has been destroyed by road construction.

New Accessories -

14" D.Fir bears N.12½°W., 52.2 ft. scribed "T31S R5W S6 CSBT" on a double blaze.

16" I.Cedar bears N.55°E., 45.9 ft. scribed "T31S R5W S5 CSBT" on a double blaze.

This corner is located approx. 30 ft. north of a newly constructed road. Compass declination 20°E.

GRAVEL

3/19/25

BLM dependent resurvey by Daniel E. Weller, Cadastral Surveyor, under Group #1884, surveyed July/Sept 1998. (DCSO records Vol. 53 Page(s) 20481)

~12 FT. TALL

The cor. of secs. 5, 6, 7, and 8, monumented with the remains of the original corner tree, a fir snag, 34" dia., with healed blaze on SE. and SW. sides, from which the remains of the original bearing trees:

23" AD. fir, 22" dia., bears N.30°E., 3 lks. with a healed blaze. <sup>20-198</sup> ALL MEASUREMENTS ARE FROM CORNER TREE

28" AP. pine, 26" dia., bears S.72¼°E., 22 lks., with a healed blaze. (Record, S.75°E., 24 lks.) <sup>14-52-15</sup>

ROTTED BROKEN 30" x 2 FT

A cedar stump, 40" dia., bears S.22°E., 46 lks., with no marks visible on opened blaze. <sup>30-86-4</sup>

9 FT TALL AD. fir snag, 19" dia., bears N.10°W., 4 lks., with a healed blaze.

and bearing trees mkd. by Langlitz, in 1975 <sup>46-20</sup>  
20" AI cedar, 17" dia., bears N.54°E., 70 lks., with scribe marks 31 R5 5CB visible on partially healed blaze. "R5" "B"

23" AD. fir, 20" dia., bears N.15¼°W., 80 lks., with a healed double blaze. <sup>52-80</sup>

and a new accessory

3 1/8" B.C. PROT. 3" A stainless steel post, 28" long, 2½" dia., set 21" in the ground for a reference monument, bears S.40°E., 5.6 lks., with brass cap mkd. RM 3.7 FT TO COR 1998 and an arrow pointing to the cor.

FD. orig. corner tree, BC RM & 6 BTs by R. Quimby 6/2016 - M171-12A&B

DECLINATION 14 1/2° E

CS 07160-9

pg 4/4