

TOWNSHIP 31S RANGE 9W SEC. 18

PLSS # 100400

Date: 3/26/25 By: KE  
This survey consists of:

Map: \_\_\_\_\_

Narrative: \_\_\_\_\_

Corner Rpt: CS 67100-12

DOUGLAS COUNTY OREGON

DATE 3-4-25

DOUGLAS COUNTY  
SURVEYOR

Corner Designation

	R10W	R9W
	513	518
Sec Cor	524	519

Monument(s) Found: (Condition and Source)

3 1/4" BLM BRASS CAP  
prof. 0.4 FT solid

\_\_\_ Condition report

\_\_\_ Not Found

\_\_\_ Renewed

\_\_\_ Unrecorded

\_\_\_ Surveyed In

Previous Renewals

J.H. Mehl III 1966 CS 55/15-2

BLM Resurvey 1993 Vol 51 pg  
19557-58

Coos County Surveyor Office

2015 CS 65/87-59

MONUMENT DETAIL

T 31S	
R10W	R9W
513	518
524	519

1993

Accessories Found

Very Rotted 34" X 2 1/2 FT FIR STUMP  
S 33° E 9.69 FT TO HEART CENTER FACE  
IN POOR CONDITION (REC S 30° E)

36" X 4 FT D. FIR STUMP S 32° W (REC S 21° W)  
19.9 TO HEART CENTER VISIBLE SCRIBES  
FACE IN FAIR CONDITION

13" X 8 FT Hemlock Stump N 26° W 8.2 FT  
Healed BLAZE

13" X 6.5 FT Hemlock Stump N 75° E (REC  
N 77° E) 12.95 FT Healed BLAZE

15" X 6.5 FT D FIR STUMP S 42° W (REC S 44° W)  
20.8 FT Healed BLAZE

15" X 1 FT D. FIR STUMP S 6 1/2° E (REC S 5° E)

14.44 FT spike in Heart Center with

Coos County washer with "X" in FACE

BEARING Diff. Due To Difference in Declination

C.S. File CS 67100-12

Monument Set (Procedure and Description)

MONUMENT DETAIL

---



---



New Accessories

---



---





Sketch of Monument, Accessories, and General Area

Location & Comments

OGRS COORDINATE SYSTEM  
 COTTAGE GROVE-CANYONVILLE ZONE  
 N. 12928.889  
 E. 33794.641

MON IS IN Newer  
 Clearcut Unit  
 Approx 90 FT West  
 OF GRAVEL Rd.

Comp. Decline. 14 1/2 E  
 Agency DCGO  
 Party Chief S. Flouse  
 Note keeper  
 Witnesses J Lorusung

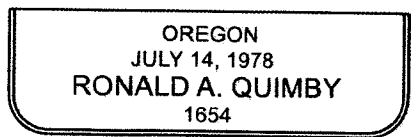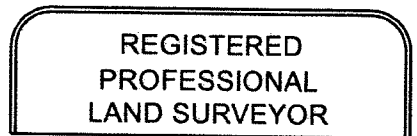

EXPIRES: 12/31/2026

CS 67/40-12 pg 2/5

PRIMARY CORNER DESCRIPTION Sec. Cor. for 18 & 19; 13 & 24, T31-10

Alias _____	Description _____
Alias _____	Description _____
Alias _____	Description _____
Alias _____	Description _____

MINI 6-15  
42.86781  
123.81925

GLO survey by Wm. H. Byars, Deputy Surveyor, under Contract #727, dated Dec. 20, 1900 - (DCSO records Vol. 19 Page(s) 8176)

-----

Set a Cedar post 4 ft. long, 4" sq., 24" in ground, for cor. of secs. 13, 18, 19 and 24, mkd. T31S S18 on NE.; R9W S19 on SE.; R10W S24 on SW.; and S13 on NW. faces, with 3 notches on N. and S. angles, from which

- A Fir 48" dia., bears S.35°E., 13 lks. dist. mkd. T31S R9W S19 BT.
- A Cedar 8" dia., bears N.65°E., 48 lks. dist. mkd. T31S R9W S18 BT.
- A Fir 40" dia., bears S.32°W., 28 lks. dist. mkd. T31S R10W S24 BT.
- A Fir 24" dia., bears N.88°W., 33 lks. dist. mkd. T31S R10W S13 BT.

T.H. Mehl, III - For: The Robert Dollar Co. - Oct. 12, 1966 - C.S. File 55/15-2

-----

Found - Corner in poor condition.

- 48" Fir BT, S.35°E., 8.6 ft., now high stump.
- 8" Cedar BT, N.65°E., 31.7 ft., removed in logging.
- 40" Fir BT, S.32°W., 18.5 ft., now high stump.
- 24" Fir BT, N.88°W., 21.8 ft., now snag stump.

For the cor., I Set a 1½" x 30" Iron pipe, 28" in the ground.

New BTs-

- 5" Hemlock N.26°W., 8.2 ft. scribed S13 RS749 BT.
- 4" Hemlock N.6°E., 5.1 ft. scribed X BT. at breast height.
- 12" W.Fir S.30½°W., 52.5 ft. scribed S24 RS749 BT.
- 13" Cedar S.25½°E., 51.9 ft. scribed S19 RS749 BT.

Reference done with staff compass and chain.

BLM resurvey by Francis J. Simon, Cadastral Surveyor, under Group #1679, Surveyed July/Oct. 1993 - (DCSO records Vol. 51 Page(s) 19557-58)

-----

The Sec. Cor., perpetuated and recorded by Mehl, in 1966, monumented with an iron pipe 1½" dia., firmly set, projecting 2" above the ground, from which the remains of the original bearing trees:

- A sawed Fir stump 38" dia., bears S.35°E., 13 lks. dist., with healed blaze.
- A sawed Fir stump 36" dia., bears S.32°W., 28 lks. dist., with healed blaze.

and bearing trees mkd. by Mehl  
(Cont. Next Page)



TOWNSHIP 31 RANGE 09 POINT IDENTIFIER # 100400

PRIMARY CORNER DESCRIPTION Sec. Cor. for 18 & 19; 13 & 24, T31-10

Alias \_\_\_\_\_ Description \_\_\_\_\_  
Alias \_\_\_\_\_ Description \_\_\_\_\_  
Alias \_\_\_\_\_ Description \_\_\_\_\_  
Alias \_\_\_\_\_ Description \_\_\_\_\_

<sup>1993</sup>  
~~1988~~: 15"  $\checkmark$  D.Fir tall stump, 6.5  $\checkmark$  tall, S. <sup>42</sup>  $\checkmark$   $44^\circ$  W.,  
28.80  $\checkmark$  to right side center. We find a healed  
 $\checkmark$  blaze with a BLM tag in place. **We paint** the face  
and a band around the stump in blue. GOOD  
CONDITION  
Note - 22" Cedar, SE BT per (C.S.) 55/15 is gone;  
12" Hemlock, SW BT per (C.S.) 55/15 is gone;  
6  $\checkmark$  Hemlock snag, NE BT (C.S.) 55/15 is down,  $\checkmark$  tag in  $\checkmark$   
place. *NO POSITION*  
New - 15"  $\checkmark$  D.Fir stump, 1  $\checkmark$  tall <sup>S  $6\frac{1}{2}^\circ$  E</sup> S.  $5^\circ$  E., 14.44  $\checkmark$  to a spike  $\checkmark$   
and Coos County washer  $\checkmark$  driven in at heart center.  
We chop an "X"  $\checkmark$  in the face, and paint the "X" and  
the top of the stump in blue and attach a yellow  
Coos County tag.  
decl.  $17^\circ$  E. *THIS WAS INCORRECT SHOULD HAVE BEEN  $15\frac{1}{4}^\circ$  E*

*WE USED  $14\frac{1}{2}^\circ$  E*  
*MONUMENT IS IN NEWER CLEARCUT APPROX. 90 FT WEST  
FROM A GRAVEL RD.*