

GOVERNMENT CORNER RESTORATION FORM

FILED

TOWNSHIP 31S RANGE 9W SEC. 19

PLSS # 140300

Date: 3/27/25 By: Ke

This survey consists of:

Map: \_\_\_\_\_

Narrative: \_\_\_\_\_

Corner Rpt: CS 07160-14

DOUGLAS COUNTY OREGON

DATE 3-26-25

DOUGLAS COUNTY  
SURVEYOR

Corner Designation

$\frac{1}{4}$  COR  $\frac{19}{30}$

Monument(s) Found: (Condition and Source)

DCSO BRASS CAP

\_\_\_ Condition report

\_\_\_ Not Found

Renewed

\_\_\_ Unrecorded

\_\_\_ Surveyed In

Previous Renewals

DCSO 1967 CS 54/32

BLM Resurvey 1993 Vol 51 pg 19559

Hostetter 2015 M 169-54

MONUMENT DETAIL

COUNTY SURVEYORS  
OFFICE

$\frac{1}{4}$  519  
530

1967

Accessories Found

Root Hole N55°W 15.8 (Rec 24 LKS)

25" x 10' Hemlock S40°E 69.3 FT (Rec 105 LKS)

Heat'd Blaze ADD 3 1/2" MAG NAIL RIGHT  
Side Center

10" x 9 FT Fir N60°E 11.2 FT (Rec 17 LKS)

ADD 3 1/2" MAG NAIL RIGHT Side Center

New Accessories

30" X 3 FT Fir Stump S50 1/2° E 69.4 FT  
3 1/2" MAG Nail Top Center

A 20" D Fir N69 1/2° W 22.7 FT Scribed  
1/4 S19 CSBT 3 1/2" MAG Nail Right  
Side Center

Sketch of Monument, Accessories, and General Area

Location & Comments


OCRS Coordinates  
Cottage Grove - Canyonville  
Zone

N 7608.787  
E 36382.624


Comp. Decline. 14 1/2° E  
Agency DCSO  
Party Chief J. Loring  
Note keeper  
Witnesses

CS 67/60-14

pg 2/3

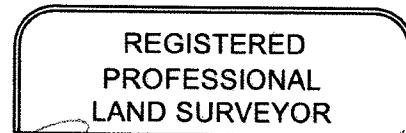

*Ronald A. Quimby*

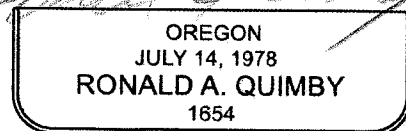

EXPIRES: 12/31/2026

