

TOWNSHIP 32S RANGE 7W SEC. 1
33

PLSS # 64400
600700

Date: 5/6/25 By: KE
This survey consists of:

DOUGLAS COUNTY OREGON

DATE 4-23-25

Map: _____
Narrative: _____
Corner Rpt: CS 67160-24

DOUGLAS COUNTY
SURVEYOR

Corner Designation

Monument(s) Found: (Condition and Source)

3/4" BLM BRASS CAP
UP 1" 2" IRON PIPE ON
NNE EDGE UP 4"

Previous Renewals

RAMSEY 1965 CS 51/310
DCSO 1967 CS 54/34-100
BLM RESURVEY 1969-1970
Vol 135 pg 14470
McINTOSH 2001 M 138-51

- Condition report
- Not Found
- Renewed
- Unrecorded
- Surveyed In

MONUMENT DETAIL

T32S R7W
534
52/51
T33S R7W
CC
1969

Accessories Found

31" x 3' high Cedar stump S35°E 13.2 FT
(REC 20 LKS)

Very Rotted 25" x 1 FT Fir stump S44°W
13.9 FT (REC 28 LKS)

28" D. Fir S10°W 6.6 FT (REC 10 LKS)
HEATED BLAZE ADD 3 1/2" MAG NAIL
RIGHT SIDE CENTER

32" D. Fir S82°E 22.3 FT HEATED BLAZE
ADD 3 1/2" MAG NAIL LEFT SIDE CENTER

2 CARSONITE Posts Labeled WITNES POST
S40°E 3.9 TO BLAZE
S50°W 3.1 TO BLAZE

New Accessories

Sketch of Monument, Accessories, and General Area

Location & Comments

MON ON FLAT Ground on
a wooded Flood plain

MON IS APPROX
30 Feet North
OF PAVED
ROAD


Leica Lat & Long

LAT 42° 44' 22.05746 N

LONG 123° 29' 04.01544 W

Comp. Decline. 74 1/2° E
 Agency DCSO
 Party Chief S. FRIESE
 Note keeper
 Witnesses J. LORSUING

CS 67160-21 pg 2/5

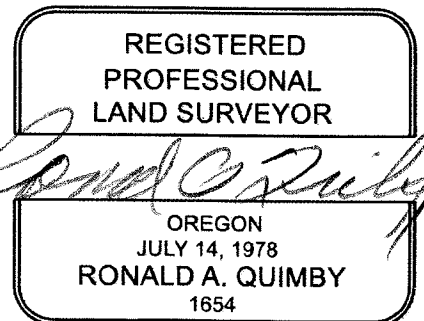

EXPIRES: 12/31/2026

PRIMARY CORNER DESCRIPTION N. Sec. cor. for 1 and 2 only, T33-7

Alias _____	Description _____
Alias _____	Description _____
Alias _____	Description _____
Alias _____	Description _____

MINI GIS
42.73959
123.48448

GLO survey by W.H. Byars, Deputy Surveyor under contract # 420 survey dated Sept 16 1881 (DCSO records Vol. 21 Page(s) 9033)

(At 10.41 chs. East of corner to secs. 35 and 36, T32-7)
 Set a Fir post, 4 ft. long, 4" sq., 24" in the ground for closing corner to secs. 1 and 2, marked C C T33S R7W on S.; S1 on E.; S2 on W.; faces, also 1 notch on E. and 5 notches on W. faces, from which

- A Cedar 36" dia., bears S.35°E., 20 lks. dist. mkd. T33S R7W S1 BT.
- A Fir 32" dia., bears S.44°W., 28 lks. dist., mkd. T33S R7W S2 BT.
- A Fir 56" dia., bears N.65°W., 21 lks. dist., mkd. T32S R7W S36 BT.

Survey by Marvin C. Ramsey - For: J.H. Baxter & Co. - Feb. 4-12, 1965 - C.S. File 51/310

Found - Orig. BT, 36" Cedar sawed stump, bears S.32°E., 20 lks., with axe marks, scribe marks burned out.
 Orig. BT, 32" D.Fir sawed stump, bears S.45°W., 28 lks. with a partial scribe mark exposed.
 Orig. BT, 56" D.Fir snag bears N.60°W., 21 lks. with axe face, marks obliterated from decay.

Set Iron pipe 3 ft. long, 2" dia., 28" in the ground mkd. RS404, from which an unmarked I.Pipe, 1" dia., 6" above ground bears S.53°E., 6 lks.

New BTs -10" D.Fir bears S.57°E., 36 lks. mkd. T33S R7W S1 RS404 BT.
 16" D.Fir bears S.10°W., 10 lks. mkd. T33S R7W S2 RS404 BT.

Douglas Co. Surveyors Office, John Powell and Frank Jones - Dec. 5, 1967 - C.S. File 54/36-100

Found - 2" I.Pipe with 4" flange at sec. cor.
 1" I.Pipe, S.53°E., 4.0 ft.
 10" D.Fir now stob, S.57°E., 23.8 ft. shows pitched over scribing.
 16" D.Fir S.10°W., 6.6 ft. shows pitched over scribing.

New BT - 12" D.Fir S.82°E., 22.3 ft. mkd. T33S R7W S1 CC CS BT.

(Cont. Next Page)

PRIMARY CORNER DESCRIPTION N. sec. cor. for 1 and 2 only, T33-7

Alias _____ Description GEO XT POSITION
 Alias _____ Description 42°44'22.491 N
 Alias _____ Description 123°29'04.154 W
 Alias _____ Description LEICA DCRS CANYONVILLE COTTAGE GROVE POS.
 Alias _____ Description 42°44'22.05746 N
 Alias _____ Description 123°29'04.01544 W

BLM resurvey by John Jelley, Rollin Aanrud, and Lynn Roseberry, Cadastral Surveyors, under Group #'s 350 and 688, surveyed May 1969/March 1970 (DCSO records Vol. 35 Page(s) 14470)

The original closing corner, perpetuated and recorded by Ramsey in 1965, with an iron pipe 2" dia., firmly set, extending 8" above ground, with bronze washer in top mkd. RS 404, from which the original bearing trees:

A sawed Cedar stump 36" dia., bears S.35°E., 20 lks. dist., with no marks visible.

A sawed Fir stump 28" dia., bears S.44°W., 28 lks. dist., with no marks visible.

The rotted remains of a Fir stump, size indeterminate, bears N.60°W., 24 lks. dist., with no marks visible. (Rec. N.65°W., 21 lks.)

and bearing trees mkd. by Ramsey

A Fir snag 10" dia. bears S.57°E. 36 lks. with open blaze.

A Fir 15" dia., bears S.10°W., 10 lks. with healed blaze.

and a bearing tree mkd. by Powell in 1967

A Fir 15" dia., bears S.82°E., 33 lks., with open blaze.

At the corner point

Set an iron post, 28 ins. long, 2 1/2 ins. dia., 24 ins. in the ground, with brass cap marked

T 32 S R 7 W

S 36

S 2 | S 1 ✓

T 33 S R 7 W

C C

1969

Reset iron pipe alongside iron post.

From this point an iron pipe 1" dia., firmly set, projecting 6" above ground, of which I have no record, bears S.61½°E., 0.06 chs. dist.

VISITED 4/23/25

James McIntosh - For: State of Oregon, Dept. of Forestry + June 2001 - M 138-51

Found 3 1/4" BLM brass cap, PROT 1" 1969 with 1965 2" pipe with bronze washer alongside (in place) - ON NNE EDGE PROT. 4"

SOLID - 36" Cedar (1881) S.35°E., 20 lks. (now 31"x3" high) 13 20
 stump in place, no marks visible.)

VERY ROTTED - 32" Fir (1881) S.44°W., 28 lks. (now 25"x21" high) 18 28
 rotted stump in place, no marks visible)

SHATTERED MOSTLY GONE - 56" Fir (1881) N.65°W., 21 lks. (now 10"x8" high) 13 06
 rotted stob in place, no marks visible.

ROTTED OUT BARK SHELL - 10" Fir (1965) S.57°E., 36 lks., (now 10"x25" high) 23 26
 rotted stob in place, axe work visible)

continued next page

OVER →
2

TOWNSHIP 32 RANGE 07 POINT IDENTIFIER # 611100

PRIMARY CORNER DESCRIPTION N. Sec. cor. for 1 and 2 only, T33-7

Alias _____ Description _____
Alias _____ Description _____
Alias _____ Description _____
Alias _____ Description _____

660 ✓
ADD 3 1/2" MAG NAIL LSC
396
28" 16" D. Fir (1965) S.10°W ✓, 10 lks (now 22" in place, face closed BT tag. ✓)
1" IP S.53°E., 6 lks. ✓ (in place)
32" 12" D. Fir (1967) S.82°E. ✓, 22.3 ✓ (now 25" in place, face closed) ✓ added BT tag. *ADD 3 1/2" MAG NAIL LSC*
Rewitnessed -
WP (Orange carsonite marker CBM-250 labeled witness post) S.40°E ✓, 3.9 ✓ to base.
WP (Orange carsonite marker CBM-250 labeled witness post) S.50°W. ✓ 3.1 ✓ to base.

MON. IS APPROX. 50 FT. NORTH FROM PAVED ROAD.
MONUMENT ON FLAT GROUND ON A WOODEN FLOODPLANE