

GOVERNMENT CORNER RESTORATION FORM

FILED

TOWNSHIP 335 RANGE 7W SEC. 4 PLSS # 340600

Date: 5/5/25 By: ke
This survey consists of:

DOUGLAS COUNTY OREGON

DATE 4-22-25

Map: _____

Narrative: _____

Corner Rpt: CS 67/60-23

Corner Designation

1/4 COR 4/9

DOUGLAS COUNTY
SURVEYOR

Monument(s) Found: (Condition and Source)

1/8 Iron Pipe projecting
8"

Condition report

Not Found

Renewed

Unrecorded

Surveyed In

Previous Renewals

Price 1954 CS 41/301

MONUMENT DETAIL

Accessories Found

BURNED - DEAD 28" CEDAR N 74 1/4° E
30.4 (REC 46 LKS) FULLY HEATED SINGLE
BLAZE

New Accessories

5/8" X 30" Iron Rod with DCSO
Plastic Cap N 54° E 53.8 FT up
2"

5/8" X 30" Iron Rod with DCSO plastic
Cap up 2" N 6° W 32.0 FT

Sketch of Monument, Accessories, and General Area

Location & Comments

MON IS NEAR TOP OF
moderate S.E slope THAT
form westerly wall of shallow
DRAW.


MON IS APPROX
30' SOUTH OF A
GRAVEL ROAD, IN
DENSE BRUSH

DCSO coordinate system
Cottage Grove - Canyonville
zone


Comp. Decline. 14 1/2' E
Agency DCSO
Party Chief S. F. HAUSE
Note keeper
Witnesses S. LOREY

N 39665.114
E 110481.865

CS 67140-23 pg 2/3

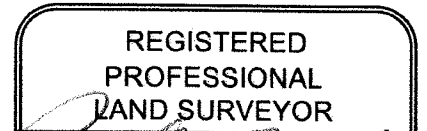

Ronald A. Quimby

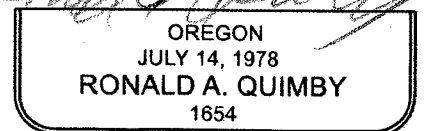

EXPIRES: 12/31/2026

TOWNSHIP 33 RANGE 07 POINT IDENTIFIER # 340600

PRIMARY CORNER DESCRIPTION 1/4 Cor. for Secs. 4 and 9

Alias _____	Description _____
Alias _____	Description _____
Alias _____	Description <u>OCS CANYONVILLE COTTAGE GROVE COORDS</u>
Alias _____	Description <u>39665.114 N</u>

110481.865E

RENEWED 4/22/25

GLO survey by Oscar F. Thiel, Deputy Surveyor, under Contract #729, dated Dec. 24, 1900 (DCSO records Vol. 21 Page(s) 9051)

Set a Fir post, 3 ft. long, 3" sq., 24" in the ground for 1/4 sec. corner, marked 1/4 S4 on N.; and 9 on S. face, from which

A Cedar 5" dia., bears N.71 1/2° E., 18 lks. dist., mkd. 1/4 S4 BT.

A Cedar 4" dia., bears S.4° E., 29 lks. dist., mkd. 1/4 S9 BT.

This corner stands 225 ft. above stream.

Survey by Norman D. Price - For: Dollar and Patterson Lumber Co. - March/Aug. 1954 - C.S. File 41/301

Determined at the record bearing and distance from the original SE bearing tree.

Set an Iron pipe, 3 ft. long, 1 1/2" dia., 28" in the ground, mkd. RS33, from which the only extant original bearing tree: An Incense Cedar 8" dia., bears S.4° E., 29 lks. dist., mkd. 1/4 S9 BT.

And a new bearing tree: An Incense Cedar 14" dia., bears N.74 1/4° E., 46 lks. dist., mkd. 1/4 S4 RS33 BT. FHSB

NEW REFS

A 5/8" x 30" I.R. / DCSO PLASTIC CAP

SET PROT ≈ 2" BEARS N 54° E,
" " " " " N 6° W,

53 1/2 FT
32 0 FT.

MONUMENT IS NEAR TOP OF MODERATE SE SLOPE THAT FORMS WESTERLY WALL OF A SHALLOW DRAW. MONUMENT IS APPROX. 50 FT. SOUTH FROM A GRAVEL RD. IN DENSE BRUSH.

MIM GIS
42.72434
123.53268

SIZE

GONE NO EVIDENCE

DEAD BURNED 28"