

TOWNSHIP 31S RANGE 9W SEC. 30 PLSS # 140 240

Date: 5/5/25 By: ke
This survey consists of:

DOUGLAS COUNTY OREGON

DATE 4-17-25

Map: _____
Narrative: _____
Corner Rpt: CS 67160-25

Corner Designation

C 1/4 530

DOUGLAS COUNTY
SURVEYOR

Monument(s) Found: (Condition and Source)

5/8" I Rod with Alum CAP
Proj 2"

- Condition report
- Not Found
- Renewed
- Unrecorded
- Surveyed In

Previous Renewals

Set by Hostetter per
M 149-54 2015

MONUMENT DETAIL

LS 1975
C 1/4
2015

Accessories Found

15" D. FIR N 52° 16' E 23.8 FT TO SPIKE
Fully Healed Single BLAZE

11" W. CEDAR N 6° 06' E 6.2 TO SPIKE
PARTLY HEALED SINGLE BLAZE Scribes
Visible (N 90° E 6.9 FT TO CENTER TREE)

6" MADRONE N 68° 57' W (REC N 68° 57' E)
3.7 FT TO SPIKE BARK Scribes Visible
(N 80° W 4.4 FT TO CENTER TREE)

Monument Set (Procedure and Description)

MONUMENT DETAIL

Blank lines for Monument Set description.

New Accessories

5" D. FIR Scribed X CS BT ON
Double BLAZE S39°W 13.9 FT

Sketch of Monument, Accessories, and General Area

Location & Comments

LAT-Long

LAT 42°50'45.668 N

LONG 123°48'34.530 E

MON ON moderate
West Slope 60° FT
Inside old Regrowth
LARGE CLEARCUT IN
S.E. QUADRANT

Comp. Decline. 14 1/2° E


Agency DCSO

Party Chief S. F. AUSE

Note keeper

Witnesses J. LORSING

CS written - 25 pg 2/3

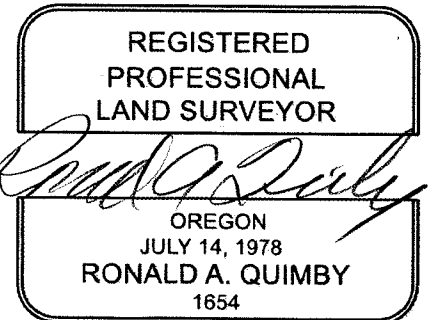

EXPIRES: 12/31/2026

PRIMARY CORNER DESCRIPTION Center 1/4 Cor. Sec. 30

Alias _____	Description <u>GEO XT POS.</u>
Alias _____	Description <u>42°50'45.653"N</u>
Alias _____	Description <u>123°48'34.460"W</u>
Alias _____	Description _____
Alias _____	Description <u>LEICA GPS</u>

MIN 615
42.84602
123.80944

Tony Hostetter - For: Plum Creek 4/2015 - M169-54 RENEWED 4/17/25

Set - $\frac{5}{8}$ "x36" iron rod w/aluminum cap marked "LS 1975 C $\frac{1}{4}$ " PROT 2"

2015" From which:

15" 12" D Fir, scribed "S30 C $\frac{1}{4}$ BT", BT tag bears N.52°16' PH 5B, FHSB
23.8 ft to spike.

11" 10" W Cedar, scribed "S30 C $\frac{1}{4}$ BT", BT tag bears
N.06°06'E., 6.8 ft to spike. PH 5B ALL SCRIB. VIS.

BEARING TO SPIKETIP →
CRC IS N09°E, 6.9 FT.

6" V Madrone, scribed "S30 C $\frac{1}{4}$ BT", BT tag bears
N.68°57' W 3.7 ft to spike. HEALED BARK SCRIBING

BEARING TO SPIKETIP →
CRC IS N80°W, 4.4 FT.

Note - No other BT available

ALL MARKS VIS.

DECLINATION 14 1/2° E

(2015 TAG HAS CORRECT BEARING)

NEW BT

5" D. FIR SCRIBED "X" "CSBT" ON HIGH-LOW BLAZE S39°W, 13.9

MONUMENT ON MODERATE WEST SLOPE ≈ 60 FT INSIDE
OLD REGROWTH LARGE RECENT CLEARCUT IN SE QUADRANT

ETREX W'14 35 - C'14 = N89°56'34"E, 2,611.88

LEICA GPS = N89°46'24"E, 2,612.10