

GOVERNMENT CORNER RESTORATION FORM

FILED

TOWNSHIP 32S RANGE 9W SEC. 8

PLSS # 300500 Date: 5/14/25 By: KE

This survey consists of:

Map: _____

DOUGLAS COUNTY OREGON

DATE 5/7/25

Narrative: _____

Corner Rpt: CS 67/60-29

Corner Designation

Sec Cor 8/9
17/16

DOUGLAS COUNTY
SURVEYOR

Monument(s) Found: (Condition and Source)

___ Condition report

GLD BRASS Cap Top Bent

___ Not Found

3/4" X 24" Iron pipe Flared Bottom

Renewed

Reference B.C Straighten AND

___ Unrecorded

Previous Renewals Reset

___ Surveyed In

GLD 1916 Vol 21 pg 8906

MONUMENT DETAIL

T 32S

58/59

517/516

R9W

1917

Accessories Found

28" X 6 FT FIR N30°E 61.0 FT (REC 91 LKS)

No FACE BLAZE but SCARING

30" X 5 1/2 FT FIR STUMP S63°E 6.6 FT PARTIAL

FACE Scribes 2 SW VISIBLE

32" X 4 FT FIR STUMP N11W 27.1 FT (REC 41 LKS)

Rotted FIR PARTIAL BARK RING N11°W
23.1 FT (REC 35 LKS)

ADD BT. TAGS TO S.E AND S.W STUMPS

New Accessories

5/8" X 30" I. ROD with DCSO plastic CAP
N 62° E 31.6 FT set in North Road
Shoulder Flush with surface

20" D. FIR N 130° E 40.7 FT scribe
T32S R9W S8 BT on Double BLAZE

Sketch of Monument, Accessories, and General Area

Location & Comments


GEO XT position
42° 797386 N
123° 775331 W

MON IS ON SOUTH
EDGE OF TIRE TRACK
OF WEST RUNNING
HELIPOND ROAD
Approx 250' E.N.E
OF HELIPOND

Comp. Decline. 14 1/2° E
Agency DCSO
Party Chief S. F. AUSE
Note keeper
Witnesses S. LORSUNG

CS 67/60-29

pg 2/4

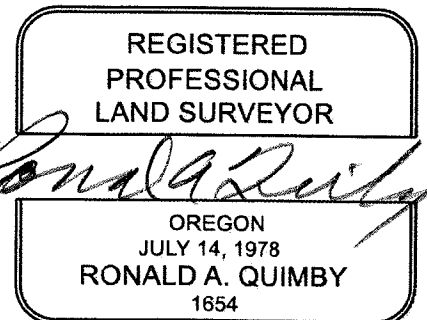

EXPIRES: 12/31/2026

TOWNSHIP 32 RANGE 09 POINT IDENTIFIER # 300500

PRIMARY CORNER DESCRIPTION Cor. Secs 8, 9, 16, & 17

Alias _____	Description _____
Alias _____	Description <u>GEO XT POSITION</u>
Alias _____	Description _____
Alias _____	Description <u>42.797386° N</u>
	<u>123.775331° W</u>

MINI GIS
42.79731N
123.77538W

GLO Dependent survey by Fred Mensch & Gerald A. Sorrels, Dep. Surveyors under special instructions dated Dec. 22, 1916 - 5/7/25 (DCSO records Vol. 21 Page(s) 8906) RENEWED

Set an iron post, 3 ft. long, 2" dia., 24" in the ground, for cor. of secs. 8, 9, 16, & 17, with brass cap mkd ALSO FND 3/4" I.D. X 24" IRON PIPE WITH FLARED BASE

B.C. MON. AND I.P. FOUND BURIED ON EDGE OF RD. TOPS BENT ~ 0.8 FT SOUTH, BUT GOOD PLUMB POSITION AT BASE. NW AND NE STUMPS BROKEN, SE AND SW STUMPS FROM WHICH STILL SOLID

28" X 6 FT. - A fir, 30" dia. bears N. 30° E, 91 lks. mkd: T32S R9W S9 BT

30" X 5 1/2 FT. - A fir, 40" dia. bears S. 63° E, 10 lks. mkd: T32S R9W S16 BT

32" X 4 FT. - A fir, 48" dia. bears N. 11° W, 35 lks. mkd: T32S R9W S8 BT

ROTTED TO GROUND PARTIAL BARK RING

PLUMB POSITION REFERENCED MONUMENTS REMOVED AND STRAIGHTENED THEN RETURNED TO REF. POSITION FND. I.P. IS SET ON SOUTH EDGE OF B.C. MON. NO FACE BUT BLZ. SCARRING PARTIAL FACE FHSB BLZ. AND FACE GONE

1917 61' 65' 23'

ADD BT TAGS TO SE AND SW STUMPS
DECLINATION 14 1/2° E

B.C. MONUMENT
PROT. 1 INCH
FND. I.P. JUST BELOW SURFACE
25 W" VISIBLE

NEW REF. S
5/8" / 30" I.R. WITH DCSO SET IN NORTH RD SHOULDER FLUSH WITH SURFACE N 62° E, 31 1/2 FT
PLASTIC CAP

20" DIA. D. FIR SCRIBED "T32SR9W S8" "BT" ON DOUBLE BLZ. N 30° E, 40 FT.

MONUMENT IS ON SOUTH EDGE OF TIRE TRACK OF WEST RUNNING HELIPOND RD. AND APPROX. 250 ENE FROM HELIPOND.

CS 6/16/0-29

pg 3/4

47

Subdivisions of T. 32 S., R. 9 W.

CHAINS	
24.00	Top of spur, slopes N.
27.30	Ravine, course N.
32.60	Creek, 2 lks. wide, course N.
39.87	Set an iron post, 3 ft. long, 1 in. diam., 26 ins in the ground, for $\frac{1}{4}$ sec. cor., with brass cap marked
	$\frac{S9}{S16}$ 1917
	from which
	A hemlock, 5 ins. diam., bears N.85*E., 22 lks. dist., marked $\frac{1}{4}$ S 9 B T.
	A fir, 24 ins. diam., bears S.72*W., 36 lks. dist., marked $\frac{1}{4}$ S 16 B T.
42.65	Creek, 2 lks. wide, course N.
49.65	Ravine, course N.
51.75	Top of spur, slopes N.
55.05	Creek, 1 lk. wide, course N.; ascend.
73.00	Top of ridge, bears NW. and SE.; along S. slope.
76.45	Trail to Cold Spring; bears NW. and SE.
79.74	The cor. of secs. 8, 9, 16 and 17.
	Land, mountainous.
	Soil, gravelly clay loam, 2nd and 3rd rate.
	Timber, fir, cedar, yew and chinquapin.
	Undergrowth, rhododendron, tan oak and fir.
	N.0*02'W., bet. secs. 8 and 9.
	Ascend through heavy timber and dense undergrowth.
1.65	Trail to Cold Spring, bears E. and W.
2.00	Top of ridge, bears E. and W.; gradually descend along E. slope.
25.60	Creek, 1 lk. wide, course E.
29.25	Creek, 1 lk. wide, course E.
38.75	Creek, 1 lk. wide, course E.
40.00	Set an iron post, 3 ft. long, 1 in. diam., 26ins. in the ground, for $\frac{1}{4}$ sec. cor., with brass cap marked

$$\frac{S8}{S9}$$
 1917

CS 67160-29 pg 4/4

GOING WEST
INTO CORNER

S 89° 57' E 2631.4'

THEN N 0° 02' W 2640'

$\frac{1}{4}$ $\frac{9}{16}$ TO $\frac{1}{4}$ 9/10

N 44° 54' 53" E, 3,724.74'

NORTH
OUT OF CORNER

POSED

N 45° 29' 02" E, 3709.5'

ACTUAL SW 9 TO S 1/4 9
N 89° 44' 50" E, 2,624.5'