

TOWNSHIP 32S RANGE 9W SEC. 14 PLSS # 540400

Date: 6/11/25 By: KE  
This survey consists of:

DOUGLAS COUNTY OREGON

DATE 5/19/25

Map: \_\_\_\_\_  
Narrative: \_\_\_\_\_  
Corner Rpt: CS 67/60-34

Corner Designation

1/4 S14  
A S23

DOUGLAS COUNTY  
SURVEYOR

Monument(s) Found: (Condition and Source)

NONE

- Condition report
- Not Found
- Renewed
- Unrecorded
- Surveyed In

Previous Renewals

BLM Resurvey 1957 Vol  
33 pg 13873

MONUMENT DETAIL

Accessories Found

BLM BRASS CAP RM N16°W 132°FT (Rec 200LKS  
MARKED 1/4 S14 T32S R9W RM 1957 AND ARROW  
POINTING TO CORNER

From which:

41" Hemlock S74°W (Rec S24W) 22.4FT (Rec  
34LKS)

47" FIR N174 1/2 E 56.1 (Rec 85LKS)

BLM BRASS CAP RM S16°E 132.0FT (Rec 200 LKS)  
MARKED 1/4 S23 T32S R9W RM 1957 WITH  
ARROW POINTING TO COR. From which,

A 27" FIR STUMP S71°W 22.4FT (Rec 34LKS)

A 33" FIR STUMP S21°E 53.5 FT (Rec 81 LKS)

Monument Set (Procedure and Description)

MONUMENT DETAIL

---



---



New Accessories

---



---



Sketch of Monument, Accessories, and General Area

Location & Comments

CCRS COORDINATES  
 Cottage Grove - Canyonville  
 Zone  
 N-18111.721  
 E 58528.946

---



---



---



---




---



---

Comp. Decline 14 1/2° E  
 Agency DCCO  
 Party Chief S. F. HOUSE  
 Note keeper \_\_\_\_\_  
 Witnesses J. L. ORSU 127

CS 67/40-34 pg 2/3

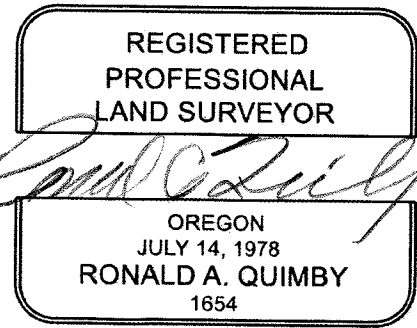

EXPIRES: 12/31/2026

PRIMARY CORNER DESCRIPTION 1/4 Cor. Secs. 14 & 23

Alias _____	Description _____
Alias _____	Description <u>OCRS CANYONVILLE COTTAGE GROVE CORNERS</u>
Alias _____	Description _____
Alias _____	Description <u>-18111.721 N</u>
	<u>58528.946 E</u>

MINIGTS  
42.78297  
123.72633

GLO Dependent survey by Fred Mensch & Gerald A. Sorrels, Dep. Surveyors under special instructions dated Dec. 22, 1916 - (DCSO records Vol. 21 Page(s) 8892)

Set an iron post, 3 ft. long, 1" dia., 26" in the ground, for 1/4 sec. cor., with brass cap marked

1/4 S 14  
S 23  
1917

from which

- A fir, 18" dia., bears N.16°E., 34 lks., mkd: 1/4 S14 BT.
- A fir, 30" dia., bears S.6°30'E., 50 lks., mkd: 1/4 S23 BT.

REV. 5/19/25

BLM remonumentation by Hans W. Thielsen, Cadastral Surveyor under Group No. 350, surveyed April 11, 1957 - (DCSO records Vol. 33 Page 13873)

The remonumentation. of the 1/4 sec.. cor, of secs 14 & 23, T32S R9W as requested the District Forester of the Medford. Forest District, BLM. The Kelsey-Mule Ck Rd is to be constructed through the corner position, and it was necessary to establish reference monuments in order to perpetuate the corner position

Point for the 1/4 cor, of secs 14 and 23, determined at record distances from the remains of the original BTs as follows:

- A sawed fir stump, 20" dia,, bears S.32°E., 32 lks. 21 1/2 marked with an open blaze. (Record bearing N.16°E.)
- A sawed fir stump, 32" dia,, bears S.6 1/2°E., 50 lks., 30 3/4 marked 23 in open blaze.

No monument established at the true corner point from the corner point

An iron post, 28" long, 2 1/2" dia set 22" <sup>132 00</sup> in the ground for a reference monument bears N.16°W., 200 lks with brass cap marked 1/4 S14 T32S R9W RM 1957 and an arrow pointing to the true corner, PROF. 12" ADD ROUGH MOUND OF STONE AROUND BASE

from which  
A fir, 32" dia., bears S. <sup>74</sup>24°W., 34 lks. marked RM 1/4 S14 BT  
A fir <sup>22 1/4</sup>34" dia., bears N.74 1/2°E., 85 lks., mkd RM 1/4 S14 BT

from the corner point <sup>56 10</sup>  
An iron. post, 48" long, 2 1/2" dia. set 22" <sup>132 00</sup> in the ground for a reference monument bears S.16°E., 200 lks. with brass cap marked 1/4 S23 T32S R9W RM 1957 and an arrow pointing to the true corner,

from which <sup>22 1/4</sup>  
A fir 27" dia bears S.71°W., 34 lks., mkd RM 1/4 S23 BT.  
A fir 33" dia., bears S.21°E., 81 lks. mkd RM 1/4 S23 BT.

53 46

41" HEMLOCK  
FOUND AS DESCRIBED BUT B.T.S ARE NOW STUMPS

CS 67160-34

pg 3/3