

GOVERNMENT CORNER RESTORATION FORM

FILED

TOWNSHIP 32S RANGE 8W SEC. 30 PLSS # 140200

Date: 6/1/25 By: ice

This survey consists of:

Map: _____

Narrative: _____

Corner Rpt: CS 67/60-35

DOUGLAS COUNTY OREGON

DATE 5/20/25

DOUGLAS COUNTY
SURVEYOR

Corner Designation

$\frac{1}{4}$ S30
S31

Monument(s) Found: (Condition and Source)

5/8" Iron Rod with plastic
cap marked Hostetter LS
1975 proj 3"

Previous Renewals

D.C.G.O 1968 - CS 54/65-29
CS 54/65-47 Not Fd
DCSO 1976 CS 59/18-26
Not Fd
Hostetter 2018 M 175-12

- Condition report
- Not Found
- Renewed
- Unrecorded
- Surveyed In

MONUMENT DETAIL

Accessories Found

10" S. Pine N 22 E 9.1 FT Dist To Tip Of
Spike

18" S. Pine S 40 E 4.81 FT Dist To Tip
of Spike

7" Fir S 69 W 8.2 FT Dist To Tip Of
Spike

11" Fir N 13 W 15.3 FT Tree Marked
by Hostetter in 2018

Monument Set (Procedure and Description)

MONUMENT DETAIL

Blank lines for Monument Set description.

New Accessories

Blank lines for New Accessories description.

Sketch of Monument, Accessories, and General Area


Location & Comments

OCRS Coordinates
Cottage Grove - Canyonville zone

N-28737.995
E 69023.816

Comp. Decline. 14 1/2° E
Agency DCSO
Party Chief S. F. AUSE
Note keeper
Witnesses J. LORSUNG

CS 67/60-35 pg 2/3

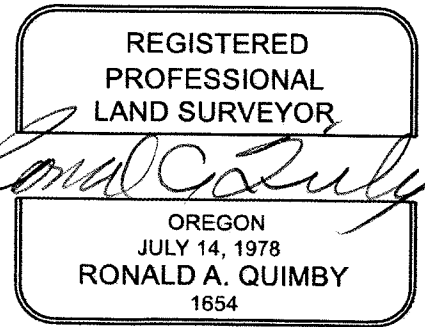

EXPIRES: 12/31/2026

5/20/25

TOWNSHIP 32 RANGE 08 POINT IDENTIFIER # 140200

PRIMARY CORNER DESCRIPTION 1/4 Cor. Secs. 30 & 31

Alias _____	Description _____
Alias _____	Description _____
Alias _____	Description _____
Alias _____	Description _____

DCRS - N - -28737.995, E-69023.816

MINI GIS
42.75372
129.68741

GLO survey by Richmond S. Dickerson, Deputy Surveyor under contract #474, dated May 10, 1883 - (DCSO records Vol. 21 Page(s) 8824)

Set a fir post 3 ft. long, 3" sq., 20" in the ground marked 1/4 S on N side for the 1/4 sec. cor., from which

A sugar pine, 50" dia., bears S.76°W., 44 lks. mkd: 1/4 S BT

A sugar pine, 6" dia., bears N.65°W., 91 lks., mkd: 1/4 S BT

Douglas Co. Surveyors Office - John M. Powell - May 1968 & June 1968 - C.S. File 54/65-29 & C.S. File 54/65-47

Reported as not found.

May 1968 - C.S. File 54/65-47

Found squared stake at approx. cor. Fits call of 5.50 chains from top of ridge.

Two large pines (BTs) not fd, believe one to be buried in fill -

Other seems to be fragmented by cat during logging operation.

June 1968 - C.S. File 54/65-29

Run east on east & west brush line.

Found logged unit at the approx. cor. & logging took out the cor. (No trace of cor.)

Douglas Co. Surveyors Office - Gary Langlitz, Deputy - Mike Tompkins - 8/26/1976 - C.S. File 59/18-26

Corner searched for and not found.

Area has been logged and has grown up in dense brush. Could not find any trees or stumps large enough to be possible BTs.

DECLINATION 14°12'E

Tony Hostetter - For: Weyerhaeuser Co. - Nov. 2018 - M175-12

Set - 5/8" X 36" iron rod with plastic cap marked "HOSTETTER LS 1975" from which: **PROT 3"** **ALL DISTANCES TO TIP OF SPIKE**

10" 9" S.Pine mkd "X" BT tag bears N.22°E., 9.1 ft to spike

18"-15" S.Pine mkd "X" BT tag bears S.40°E., 4.81 ft to spike.

7" 6" Fir, mkd "X", BT tag, bears S.69°W., 8.2 ft to spike

~~9" S.Pine mkd "X" BT tag bears N.13°E., 8.2 ft to spike~~

"X" IS CHOPPED IN BARK AND THROUGH CAMBIUM ~ 4 FT ABV GRND

11" FIR, N 13 W, 15³ FT - MARKED BY **MADE UP TREE**

HOSTETTER IN 2018.

ALL TREES HAVE 8" SPIKES IN FACE.