

TOWNSHIP 32S RANGE 8W SEC. 21 PLSS # 400306

Date: 6/11/25 By: ke  
This survey consists of:

DOUGLAS COUNTY OREGON

DATE 5/20/25

Map: \_\_\_\_\_  
Narrative: \_\_\_\_\_  
Corner Rpt: CS67/40-36

Corner Designation

21/22  
28/27

DOUGLAS COUNTY  
SURVEYOR

Monument(s) Found: (Condition and Source)

2 1/2" DC SO BRASS CAP  
proj. 8"

- Condition report
- Not Found
- Renewed
- Unrecorded
- Surveyed In

Previous Renewals

DC SO 1968 CS 54/65-24  
DC SO- GIS 2004 CS 67/33-1

MONUMENT DETAIL

COUNTY SURVEYORS  
OFFICE  
T32S R8W  
521 | 522  
528 | 527  
1968

Accessories Found

48" D. FIR N 28°W 42.6 FT Fully Healed  
SINGLE BLAZE  
18" LAUREL N 7°E 58.5 FT Fully Healed  
SINGLE BLAZE  
29" D. FIR S 60°E 9.5 FT (REC 9.9) Fully  
Healed SINGLE BLAZE ADD 3 1/2" NING NAIL  
RIGHT SIDE CENTER

New Accessories

13" D. FIR S47°W 14.0 FT Scribed  
T32S R8W528CS BT ON Double  
BLAZE 3 1/2" MAG Nail set Left Side  
Center

Sketch of Monument, Accessories, and General Area

Location & Comments


OCRS COORDINATES  
Cottage Grove - Canyonville  
zone

MON IS APPROX  
20 FT WEST OF  
ROAD ON STEEP  
N. W. slope

N-23782.282  
E 81706.445

Comp. Decline. 14 1/2° E  
Agency DCSO  
Party Chief S.F. HAUSE  
Note keeper  
Witnesses J. LORSUNG

CS 67/60-36 pg 2/3

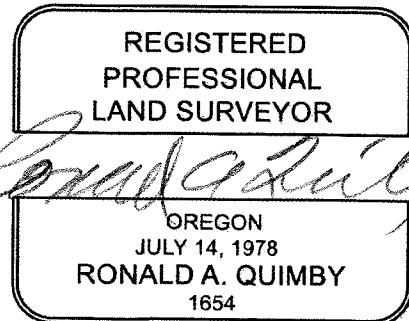

EXPIRES: 12/31/2026

TOWNSHIP 32 RANGE 08 POINT IDENTIFIER # 400300

PRIMARY CORNER DESCRIPTION Cor. Secs. 21, 22, 27, & 28

Alias _____	Description _____
Alias _____	Description <u>DCRS CANYONVILLE COTTAGE GROVE COORDS.</u>
Alias _____	Description _____
Alias _____	Description <u>-23782.282 N</u>
	<u>81706.445 E</u>

GLO survey by Richmond S. Dickerson, Deputy Surveyor under contract #474, dated May 10, 1883 - (DCSO records Vol. 21 Page(s) 8805)

A Chinquapin, 6" dia., which I mark T32S R8W S22 on NE, S27 on SE, S28 on SW, and S21 on NW faces, also 2 notches on the S and three notches on the E angle of same for the corner to secs. 21, 22, 27 and 28, and from which

- A Laurel, 8" dia, bears N.70°E. 97 lks mkd T32S R8W S22 BT
- A Fir, 8" dia., bears S.60°E., 15 lks. mkd T32S R8W S27 BT
- A Laurel, 8" dia. bears S.60°W. 80 lks mkd T32S R8W S28 BT
- A Pine, 12" dia. bears N.14°W. 50 lks. mkd T32S R8W S21 BT

*RENEWED 5/20/25*

Douglas Co. Surveyors Office - John M. Powell - Frank Jones & W. Penley - May 1968 - C.S. File 54/65-24

Found - 8", now 16" D.Fir, S.60°E. 9.9 ft. This tree had been opened but buried in fill of road. Dug out to find part of "BT". All other trees gone from road construction.

Set - Brass Cap at Cor. mkd: County Surveyors Office T32S R8W S 21 | S 22 S 28 | S 27 1968

*16" FALLEN SLID DOWNHILL NO POSITION*

New BTs - ~~12" Laurel S.35°W, 62.0 ft. Mkd. T32S R8W S28 CS BT.~~

*48" 28" D. Fir N.28°W, 42.6 ft. mkd. T32S R8W S21 CS BT.*

*18" 10" Laurel N.7°E, 58.5 ft. Mcd. T32S R8W S22 CS BT.*

Reblazed & Rescribed -

Note - *29" 16" D. Fir S.60°E, 9.9 ft. mkd. T32S R8W S27 CS BT.* This corner lies approx. 60 ft. west of road.

*ON STEEP NW SLOPE*

*ADD 3 1/2" MAG NAIL R.S.C. THIS TREE*

DCSO-GIS Corner visitation - 1/29/2004 - Typed: 2/10/2011 C.S. File 67/33-1

Monument - *1 1/4" IP/BC*

Comment - ok

*DECLINATION 14 1/2° E*

*NEW REFERENCE*

*13" DBH D. FIR SCRIBED "T32SR8WS28CS" BT ON DOUBLE BLAZE S47°W, 14° FT. HAS A 3 1/2" MAG NAIL SET L.S.C.*

*MINI GIS  
42.76777  
123.63993*