

TOWNSHIP 32S RANGE 8W SEC. 14 PLSS # 540400

Date: 6/11/25 By: ke
This survey consists of:

DOUGLAS COUNTY OREGON

DATE 5/21/25

Map: _____
Narrative: _____
Corner Rpt: CS 67/60-37

DOUGLAS COUNTY
SURVEYOR

Corner Designation

$\frac{1}{4}$ $\frac{514}{523}$

Monument(s) Found: (Condition and Source)

3/4" BLM BRASS CAP
proj. 5"

- Condition report
- Not Found
- Renewed
- Unrecorded
- Surveyed In

Previous Renewals

SWearingen 1960 CS 51/63-4
BLM Resurvey 1973-1975
Vol 40 pg 15981
BLM Resurvey 2014 Vol
58 pgs 23262-3

MONUMENT DETAIL

T32S 8W
 $\frac{1}{4}$ $\frac{514}{523}$
1975

Accessories Found

12" MADRONE N 40 1/2° E 16.3 FT Healed
Double BLAZE

47" D. F. pipe S 19° E 45.5 (Rec 42.6)
Healed Double BLAZE

7/8" steel Rod along side Proj. 8"

New Accessories

9" TAN OAK S 48° E 23.0 FT scribe
 1/4 523 CS BT ON Double BLAZE

Sketch of Monument, Accessories, and General Area


Location & Comments

OCRS Coordinates
 Cottage Grove - Canyonville
 zone

N-18280.281
 E 88989.453

Comp. Decline. 14 1/2° E
 Agency DCSO
 Party Chief S. F. FAUSE
 Note keeper
 Witnesses J. LORSUNG

CS 67160-37 pg 2/4

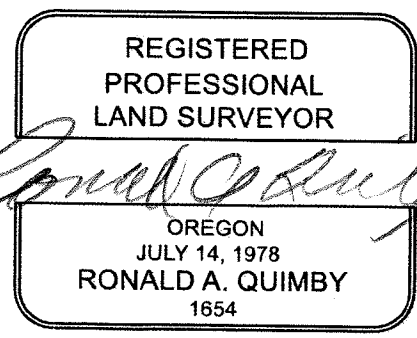

EXPIRES: 12/31/2026

TOWNSHIP 32 RANGE 08 POINT IDENTIFIER # 540400

PRIMARY CORNER DESCRIPTION 1/4 Cor. Secs. 14 & 23

Alias _____	Description _____
Alias _____	Description _____
Alias _____	Description _____
Alias _____	Description _____

MINI GIS
42,78281
123,61290

GLO survey by Richmond Dickerson, Deputy Surveyor under contract #474, dated May 10, 1883 - (DCSO rec Vol 21 Pg 8798)

Set a stone 18x10x5", 12" in the ground for 1/4 sec. cor. mkd. 1/4 on N face and from which

A laurel, 5" dia., bears N.60°E., 26 lks., mkd: 1/4 S BT.

A pine, 10" dia., bears S.42°E., 50 lks., mkd: 1/4 S BT.

Lorne Swearingen - For: Robert Dollar Co. - Witness: Robert A Harris & Milner Larson - April 15, 1960 - C.S. File 51/63-4

Found to be in very poor condition.

The corner was a stone which was still in place but badly broken.

The orig. BT for sec. 14 had rotted away.

The BT for Sec. 23 is a pine snag broken off just above the scribed face.

I marked the corner with a 7/8"x30" hex drill steel driven 20" in the ground from which I referenced a:

6" Laurel N.40 1/2°E., 16.3 ft., scribed 1/4 S 4186 BT.

30" Fir S.20°E., 42.4 ft., scribed 1/4 S 4186 BT.

BLM dependent resurvey by Lynn M. Roseberry and Rollin D. Aanrud, Cadastral Surveyors, Group #821 & 876, surveyed July 1973/July 1975 - (DCSO records Vol. 40 Page(s) 15981)

The 1/4 sec. cor. of secs. 14 and 23, perpetuated and recorded by Swearingen, in 1960, monumented with a steel rod, 7/8" dia., firmly set, projecting 10" above ground, alongside of which is a broken basalt stone, no marks visible, from which the remains of the original bearing trees:

A ponderosa pine snag, 18" dia., bears S.40 1/2°E., 50 lks., with scribe marks 1/4 S BT visible on opened double blaze. (Record, S.42°E.)

and bearing trees mkd. by Swearingen

A madrone, 8" dia. bears N.40 1/2°E. 26 lks with scribe marks 1/4 S 4186 BT visible on partially healed double blaze.

A fir, 36" dia., bears S.19°E., 66 lks., with scribe marks 1/4 S 4186 BT visible on partially healed double blaze.

At the corner point

Set an iron post, 28" long, 2 1/2" dia., 24" in the ground, with brass cap marked:

T32S R8W
1/4 $\frac{S\ 14}{S\ 23}$
1975

Deposit remains of stone & reset steel rod alongside iron post.

cont.

CS 67/60-37 pg 3/4

TOWNSHIP 32 RANGE 08 POINT IDENTIFIER # 540400

PRIMARY CORNER DESCRIPTION 1/4 Cor. Secs. 14 & 23

Alias _____	Description _____
Alias _____	Description <u>OCRS CANYONVILLE COTTAGE GROVE COOP. S</u>
Alias _____	Description _____
Alias _____	Description <u>-18280.281N</u>

88989.453E

RENEWED 5/21/25

BLM dependent resurvey by Kevin G Mulder, Cadastral Surveyor, under Group No. 2741; Surveyed March/April 2014 - (DCSO records Vol. 58 Page(s) 23262-3)

3/4" BC PROPERLY MARKED

The 1/4 sec. cor. of secs. 14 & 23, monumented with an iron post, 2 1/2" dia., firmly set, projecting 5" above the ground, with brass cap (properly) mkd.

from which BTs mkd. by Swearingen, in 1960

12" A madrone, 1 1/2" dia., bears N. 40 1/2° E, 16.3 ft., with a healed double blaze (Record, 17.2 ft.)

47" AD fir, 45" dia., bears S. 19° E, 42.6 ft., with a healed double blaze (Record, 43.6 ft.) 45 1/2

Alongside the iron post is a steel rod, 7/8" dia., firmly set, projecting 10" above the ground.

NEW REFERENCE

A 9" DIA. TANOAK SCRIBED "1/4 S 23" "CSBT" ON A DOUBLE BLAZE, BEARS S 48° E, 23° FT. DIST.

CS 67/60-37

pg 4/4

TAN OAK
9" DIA. S 48 E 23°

"CSBT"