

TOWNSHIP 32S RANGE 9W SEC. 15

PLSS # 400440

Date: 6/11/25 By: le

This survey consists of:

DOUGLAS COUNTY OREGON

DATE 6-2-25

Map: _____

Narrative: _____

Corner Rpt: CS 67/10040

Corner Designation

DOUGLAS COUNTY
SURVEYOR

1/4 COR 516/515

Monument(s) Found: (Condition and Source)

___ Condition report

2 1/2" DCSD BRASS CAP
PROJ 15" IN ROUGH STONE
MOUND AROUND BASE

___ Not Found

Renewed

___ Unrecorded

Previous Renewals

___ Surveyed In

DCSD 1967 CS 54/44-70

MONUMENT DETAIL

COUNTY SURVEYORS
OFFICE

1/4 516/515
1967

Accessories Found

41" D. FIR S 82° E (REC S 88° E) 32.3 FT
Fully Healed Single BLAZE

35" D. FIR N 31° W (REC N 34° W) 17.8 FT
Fully Healed Single BLAZE

Monument Set (Procedure and Description)

MONUMENT DETAIL

New Accessories

5" D. FIR N 167° E 8.0 FT Scribed
"X" BT ON Double BLAZE

7" D. FIR S 22° W 10.3 FT Scribed
"X" BT ON Double BLAZE

Sketch of Monument, Accessories, and General Area

Location & Comments


ORCS COORDINATES
Cottage Grove - Canyonville
Zone

MON 15 100'± N. OF
DIRT ROAD ON HIGH
RIDGE RUNNING
E-W

N-15484.453
E 50664.627

Comp. Decline. 14 1/2° E
Agency DCSO
Party Chief S. F. Rouse
Note keeper
Witnesses J. L. Larson

CS 67160-40
pg 2/3

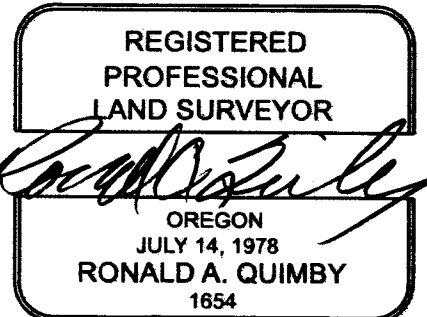

EXPIRES: 12/31/2026

TOWNSHIP 32 RANGE 09 POINT IDENTIFIER # 400440

PRIMARY CORNER DESCRIPTION 1/4 Cor. Secs. 15 & 16

Alias _____	Description _____
Alias _____	Description _____
Alias _____	Description <u>OGRS CANYONVILLE COTTAGE GROVE COORD.S</u>
Alias _____	Description _____

MINING
42.79014
123.75572

75484.453 N
50664.627 E

GLO Dependent survey by Fred Mensch & Gerald A. Sorrels, Dep. Surveyors under special instructions dated Dec. 22, 1916 - (DCSO records Vol. 21 Page(s) 8899)

Set an iron post, 3 ft. long, 1" dia., 26" in the ground, for 1/4 sec. cor., with brass cap marked

✓ 1/4
S 16 | S 15
1917

2 1/2" BC / 1" DIP PROT. 15"

ADD ROUGH MND. OF STN. AROUND BASE

from which

A fir, 30" dia., bears S.88°E., 49 lks., mkd: 1/4 S15 BT.

A fir, 16" dia., bears N.34°W., 27 lks., mkd: 1/4 S16 BT.

RENEWED 6/2/25

Douglas Co. Surveyors Office - John M. Powell - Frank Jones & Joe Brady - July 1967 - C.S. File 54/44-70

Found - Rod of GLO Brass Cap. ^{85°} Corner is close to campground.

41" 30", now 35" D. Fir S.88°E. 32.3 ft. shows good scar. FHSB

35" 16", now 24" D. Fir N.34°W. 17.8 ft. shows good scar. FHSB

Set Brass Cap at 1/4 Corner mkd: County Surveyors T32S R9W 31° Office, 1967 1/4 S 16 | S 15 (SEE ABOVE)

Note - Bearing Trees are tagged and in good condition. DIRT ROAD ON
This corner lies ~~70~~ 100' N. of high ridge running E. & W. & approx. 300' N. of Cold Spring Campground Road. Location Tag on S. side of Road.

DECLINATION 14' 12" E

OLD NAME

NEW REFERENCES

5" DIA. D. FIR SCRIBED "X" "BT" ON HIGH-LOW BLAZE; BEARS N67°E, 80 FT.

7" DIA. D. FIR " " "X" "BT" " " " ; BEARS S22°W, 103 FT.

CS 67160-40

pg 3/3

N04°05'02"W, 2636'