

GOVERNMENT CORNER RESTORATION FORM

FILED

TOWNSHIP 32S RANGE 9W SEC. 15 PLSS # 400400

Date: 6-19-25 By: KE  
This survey consists of:

DOUGLAS COUNTY OREGON

DATE 6-11-25

Map: \_\_\_\_\_

Narrative: \_\_\_\_\_  
Corner Rpt: CS 67160-42

Corner Designation

SECTOR 516/515  
521/522

DOUGLAS COUNTY  
SURVEYOR

Monument(s) Found: (Condition and Source)

\_\_\_ Condition report

2 1/2" BRASS CAP ON IRON  
PIPE PARTLY BURIED TIPPED  
STRAIGHT DOWN HILL BT MEASURED  
PREVIOUS RENEWALS TO BASE OF PIPE

\_\_\_ Not Found

Renewed

\_\_\_ Unrecorded

\_\_\_ Surveyed In

SET BY GLD 1917 VOL  
21 PGS 8897-8

MONUMENT DETAIL

T 32S R 9W  
516/515  
521/522  
1917

Accessories Found

15" CHINGUAPIN S72°E 7.90 FT (REC 12 LKS)  
PARTLY HEALED FACE ROTTED ADD 3 1/2" MAG  
NAIL RIGHT SIDE CENTER

42" X 2 FT SAWN D. FIR STUMP S60W 19.8 FT  
(REC 19 LKS) FULLY HEALED SINGLE BLAZE ADD  
6" SPIKE TOP CENTER

37" D. FIR N42°W 21.1 FT (REC 32 LKS)  
FULLY HEALED SINGLE BLAZE ADD 3 1/2"  
MAG NAIL RIGHT SIDE CENTER

RENEWAL

Monument Set (Procedure and Description)

MONUMENT DETAIL

Reference mon base  
Reset mon with cap  
At Reference position  
proj. 10" Rough stone  
Mound constructed around  
Base of mon.

New Accessories

5" Chingupin south 10.9 FT scribed  
"X" BT on Double Blaze 3 1/2" MAG  
Nail Right side center

Sketch of Monument, Accessories, and General Area


Location & Comments

Mon on steep WSW slope  
in very old thinned fir  
and Chingupin

Mon approx 150  
ft west of  
Gravel Road

Trimble Geo XT position  
42° 46' 58.494" N  
123° 45' 20.730 W

Comp. Decline. 14 1/2° E  
Agency DCSO  
Party Chief J. F. Inuse  
Note keeper  
Witnesses J. Loring

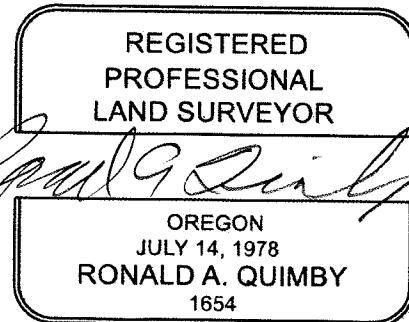

EXPIRES: 12/31/2026

CS 67/60-42

pg 2/3

TOWNSHIP 32 RANGE 09 POINT IDENTIFIER # 400400

PRIMARY CORNER DESCRIPTION Cor SEcs 15, 16, 21, & 22

Alias _____	Description _____
Alias _____	Description _____
Alias _____	Description <u>TRIMBLE GEO XT POSITION</u>
Alias _____	Description _____

42° 46' 58.494" N  
123° 45' 20.730" W

GLO Dependent survey by Fred Mensch & Gerald A. Sorrels, Dep. Surveyors under special instructions dated Dec. 22, 1916 - (DCSO records Vol. 21 Page(s) 8897-8)

RENEWED 6/11/25

Set an iron post, 3 ft. long, 2" dia., 24" in the ground, for cor. of secs. 15, 16, 21, & 22, with brass cap mkd

DECLINATION 14 1/2° E

2 1/2" B.C.  
T32S R9W S16 S15  
S 21 S 22  
1917

CAP FOUND PARTIALLY BURIED AND TIPPED STRAIGHT DOWN HILL  
BT MEASUREMENTS MADE FROM BASE OF I.P. AS FOUND.

from which

POSSIBLE ROOT DEPRESSION

A chinquapin, 14" dia., bears N.48°E., 16 lks., mkd: T32S R9W S15 BT.

15" A chinquapin, \*5 14" dia., bears S.72°E., \*2 12 lks., mkd: T32S R9W S22 BT. (\*14" not 5" and 12 lks not 2 lks per research 6/10/2025 JC DCSO) 198 ✓

BLAZE PARTIALLY HEALED, FACE ROTTED

36" Adfir, 36" dia. bears S.60°W 30 lks. mkd: T32S R9W S21 BT FHSB  
37" Adfir, 30" dia. bears N.62°W 32 lks. mkd: T32S R9W S16 BT FHSB

SAWN STUMP

ADD 6" SPIKE NAIL TO TOP CENTER OF FOUND SW STUMP  
ADD 3 1/2" MAG NAIL R.S.C. TO THE TWO OTHER FOUND BT'S

FOUND POSITION OF MONUMENT BAS IS REFERENCED OUT.  
A NEW HOLE IS DUG AT REFERENCED POSITION. FOUND B.C. (I.P.) MONUMENT IS SET AT THE REFERENCED POSITION PROTRUDING 10 INCHES ABOVE THE GROUND. A ROUGH MOUND OF STONE IS BUILT AROUND BASE OF MONUMENT.

NEW REF.

A 5" DIA. CHINQUAPIN SCRIBED "X" "BT" ON A HIGH-LOW BLAZE BEARS SOUTH 109 FT. DISTANT  
A 3 1/2" MAG NAIL IS PLACED R.S.C.

MONUMENT ON STEEP WSW SLOPE IN VERY OLD THINNEN FIR AND CHINQUAPIN. MON IS APPROX 150 FT. WEST OF GRAVEL RD.