

TOWNSHIP 32S RANGE 8W SEC. 18 PLSS # 100440

Date: 6-19-25 By: 14
This survey consists of:

DOUGLAS COUNTY OREGON

DATE 6-4-25

Map: _____
Narrative: _____
Corner Rpt: CS 67160-45

DOUGLAS COUNTY
SURVEYOR

Corner Designation

W 1/4 518 only

Monument(s) Found: (Condition and Source)

2 1/2" GLO BRASS CAP
Proj 7"

- Condition report
- Not Found
- Renewed
- Unrecorded
- Surveyed In

Previous Renewals

GLO RESURVEY 1916 Vol
21 pg 8844
DCSO 1967 CS 54/44-57

MONUMENT DETAIL

1/4
| 518
1917

Accessories Found

SAWN PARTLY ROTTED 52" X 3 FT D. FIR
Stump N71°E 42.9 FT OPEN FACE SCRIBE
1/4 VISIBLE
SAWN 16" X 3 1/2 FT SUGAR PINE STUMP
S 69°E 64.0 FT BARK GONE SHOWS
GOOD SCAR
9" CHINQUAPIN (RECTAN OAK) S34°W 9.6 FT
FULLY HEALED DOUBLE BLAZE
44" X 12 FT BROKEN SNA9 SUGAR PINE N30°W
30.4 FT PORTION OF TREE BROKEN OFF
FALLEN ON FACE

Horizontal lines for Monument Set (Procedure and Description)

New Accessories

Horizontal lines for New Accessories

Sketch of Monument, Accessories, and General Area

Location & Comments

CORNER IN OLDER FIR
CHINQUAPIN AND TAN OAK
REGROWTH ON STEEP N1/E
SLOPE

MON IS APPROX
120 FT EAST OF
SHARP CURVE IN
MAIN DIRT RD


OCRS COTTAGE GROVE
CANYONVILLE POSITION

Comp. Decline. $14\frac{1}{2}^{\circ} E$
Agency DCSO
Party Chief S. F. HAUSE
Note keeper
Witnesses J. LORSUNG

$42^{\circ} 47' 18.19607 N$
 $123^{\circ} 41' 50.03590 W$

CS 67160-45

pg 2/3

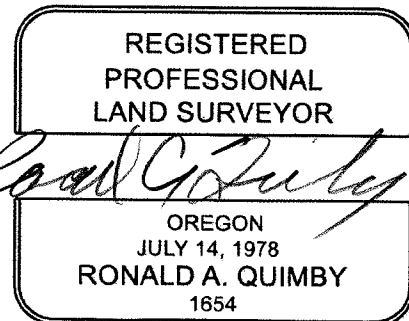

EXPIRES: 12/31/2026

PRIMARY CORNER DESCRIPTION W. 1/4 Cor. for Sec. 18 only

Alias _____	Description _____
Alias _____	Description _____
Alias _____	Description <u>DCRS CANYONVILLE COTTAGE GROVE PDS.</u>
Alias _____	Description _____

42° 47' 18.19607" N
123° 41' 50.03590" W

GLO survey by Richmond S. Dickerson, Deputy Surveyor, under Contract #474, dated May 10, 1883 - (DCSO records Vol. 21 Page(s) 8778)

Set a Fir post 3 ft. long, 3" sq., 20" in the ground for the 1/4 sec. cor. mkd. 1/4 on W. side, and from which

A Fir 48" dia., bears N.71°E., 65 lks. dist. mkd. 1/4 S BT.

A Sugar Pine 36" dia., bears N.36°W., 42 lks. dist. mkd. 1/4 S BT.

GLO Resurvey by Fred Mensch and Gerald A. Sorrels, Surveyors under Special Instructions, Group #35, dated Dec. 22, 1916 - (DCSO records Vol. 21 Page(s) 8844)

Intersect at the old 1/4 sec. cor, which is a decayed and partly burned post, witnessed as described by the surveyor general. I change this cor. to refer to sec. 18 only and perpetuate it as follows: alongside the old cor.

Set an iron post 3 ft. long, 1" dia., 26" in the ground for 1/4 cor., with brass cap mkd.

2 1/2" BC | 1/4 S18 ✓ PROT 7"
1917

from which

A Fir 48" dia., bears N.71°E., 65 lks. dist. mkd. 1/4 S18 BT (Old BT)

A Sugar Pine 16" dia., bears S.69°E., 97 lks. dist. mkd. 1/4 S18 BT (New BT)

RENEWED 6/4/25

Douglas Co. Surveyors Office - John M. Powell, and crew - July 1967 - C.S. File 54/44-57

Found - 1917 GLO brass cap, properly marked. (SEE ABOVE)

48" D. Fir ✓ now 52" ✓ stump, N.71°E ✓, 42.9 ✓ ft., opened and shows good scribe "1/4" ✓

SAWN PARTLY ROTTEN 52" X 3 FT. TALL
SAWN BARK GONE 16" X 3 1/2 FT. TALL

16" Sugar Pine ✓ now 17" ✓ stump, S.69°E ✓, 64.0 ✓ ft., shows good scar ✓

44" X 1/2 FT TALL BROKEN SNAG

9" CHINO ✓
New BTs - ~~5" Tan Oak~~ S34°W ✓, 9.6 ✓ ft. mkd. S18 CS BT. FHDB

48" Sugar Pine ✓ N.30°W ✓, 30.4 ✓ ft. mkd. 1/4 S24 CS BT. ✓

There are no other trees in range 8 to scribe. PORTRION OF TREE CORNER LIES ON THE W. OF A CUTTING LINE. BROKEN OFF, FALLEN ON FACE

CORNER IN OLDER FIR, CHINQUAPIN AND TAN OAK REGROWTH ON A STEEP NNE SLOPE,
MONUMENT IS APPROX 120 FT. EAST FROM SHARP CURVE IN MAIN DIRT ROAD.