

GOVERNMENT CORNER RESTORATION FORM

FILED

TOWNSHIP 27S RANGE 3W SEC. 35 PLSS # 5401A0

Date: 7/8/25 By: ke
This survey consists of:

DOUGLAS COUNTY OREGON

DATE 2-17-19

Map: _____

Narrative: _____
Corner Rpt: CS 67160-48

Corner Designation

DOUGLAS COUNTY
SURVEYOR

C 1/4 S 35

Monument(s) Found: (Condition and Source)

Condition report

BLM 3 1/2" BRASS CAP

Not Found

Proj 3"

Renewed

Unrecorded

Previous Renewals

Surveyed In

Set by BLM 1985 Vol
48 pg 18222

MONUMENT DETAIL

U.S DEPT INTERIOR
BUR OF LAND
MANAGEMENT

T27S R2W
C 1/4 S35
1985

Accessories Found

21" Fir S88°E 18.0 FT (REC 2 BLKS)

18" D Fir S70W 7.9 FT (REC 12 LKS) Fully
Healed Low BLAZE

New Accessories

17" D Fir N50°E 20.7 FT Scribed
C 1/4 535 CS BT

18" D. Fir N26 1/2°W 17.4 FT Scribed
C 1/4 535 CS BT

Sketch of Monument, Accessories, and General Area

Location & Comments

COR IS APPROX
150 FT WEST OF
ACCESS ROAD

Comp. Decline. 14 3/4° E
Agency DCSO
Party Chief S.F. HUSE
Note keeper
Witnesses J. LORSUNG

CS 67160 - 48
pg 2 / 5

REGISTERED
PROFESSIONAL
LAND SURVEYOR

OREGON
JULY 14, 1978
RONALD A. QUIMBY
1654

EXPIRES: 12/31/2026

T 27 R 3 S 35 ALSS: 540140
DATE: 2-13-2019

CREW: S.J. FLAUSE
JEFF LORSUNG

MONUMENT:

3 1/4" B.C. ON 2" I.P.
MARKED AS PER RECORD

PROJ: 3"

FOUND:

BLM 1985:

- 21" D. FIR, S. 88° E., 18⁰ FT, FHDB.
(REC. 7" , 18 4/8")

- 18" D. FIR, S. 70° W., 7⁹², FHDB.
(REC. 5")

NEW:

- 17" D. FIR, N. 50° E., 20⁷ FT.
SCRIBED "C1/4 3535", "BT"


- 18" D. FIR, N. 26 1/2° W., 17 1/2 FT.
SCRIBED "C1/4 335", "CSBT"

150' WEST OF ACCESS RD.

CS 67/60-48

PG 3/5

SKETCH

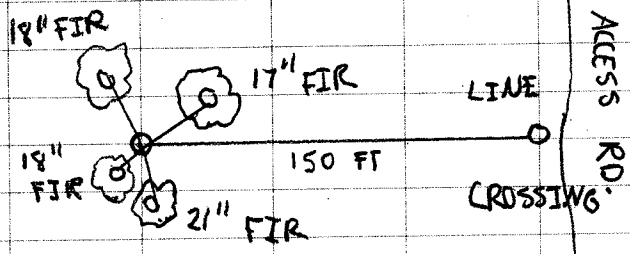

CS 67160-418
pg 4/5

DEC: 14 ³/₄

TOWNSHIP 27 RANGE 03 POINT IDENTIFIER # 540140

PRIMARY CORNER DESCRIPTION Center 1/4 Cor. Sec. 35

Alias _____	Description _____
Alias _____	Description _____
Alias _____	Description _____
Alias _____	Description _____

BLM Dependent resurvey by Boyd W. Peterson & Mark D. Dixon, Cadastral Surveyors, under Group #1268, surveyed May/Sept. 1985 - (DCSO records Vol. 48 Page(s) 18222)

Point for the center 1/4 sec. cor. of sec. 25, at intersection with the E & W center line.

Set an iron post, 28" long, 2 1/2" dia., 25" in the ground, with brass cap marked: *3 1/4 BC / 2" IP* T27S R3W *1849*

PROJ 3" C 1/4 S35 1985 *180*

from which *1849* 21" A fir, 7" dia., bears S.88°E., 28 lks., mkd: C 1/4 S35 BT.

1849 18" A fir, 5" dia., bears S.70°W., 12 lks., mkd: X BT. *FHM 10/13/85*

Deposit white "DEEP-1" magnetic marker at base of stainless steel post. *1792 v*

NEW HTs

17" D, FIR "C 1/4 S35 55" "BT" N 50° E, 20 I

18" D, FIR "C 1/4 S35 55" "BT" N 26 1/2° W, 17 1/4

150' WEST FROM 5225513000 211

CS 67140-48 pg 5/5