

TOWNSHIP 32S RANGE 9W SEC. 13

PLSS # 600400 Date: 7/8/25 By: VC

This survey consists of:

Map: \_\_\_\_\_

DOUGLAS COUNTY OREGON

DATE 6-19-25

Narrative: \_\_\_\_\_

Corner Rpt: CS 67160-50

Corner Designation

DOUGLAS COUNTY  
SURVEYOR

Sec. Cor 14/18  
23/24

Monument(s) Found: (Condition and Source)

\_\_\_ Condition report

\_\_\_ Not Found

Renewed

\_\_\_ Unrecorded

\_\_\_ Surveyed In

GLO 2 1/2" BRASS CAP  
PROJ 16" ADD ROUGH  
MOUND OF STONE AROUND BASE

Previous Renewals

DCSD 1967 CS 54/44-15

MONUMENT DETAIL

T32S R9W  
514/515  
523/524  
1917

Accessories Found

30" X 2 FT ROTTED BROKEN FIR STUMP N80°E  
83.8 FT BLAZE GONE  
34" X 8 FT ROTTED SAWN FIR STUMP S78°E  
83.3 FT  
45" X 3 1/2 FT ROTTED SAWN FIR STUMP S44 1/2°W  
DIST NOT CHECKED TREES OR LIVE  
40" D. FIR N151°W 82.5 (REC 80.5) DIST. TO 3 1/2"  
MAG NAIL SET LEFT SIDE CENTER  
22" D. FIR N19°W 15.0 FT FULLY HEATED DOUBLE  
BLAZE ADD 3 1/2" MAG NAIL RIGHT SIDE CENTER  
11" D. FIR N72°E 8.0 FT FULLY HEATED DOUBLE  
BLAZE ADD 3 1/2" MAG NAIL RIGHT SIDE CENTER  
17" D. FIR S11°E 29.7 FT FULLY HEATED DOUBLE  
BLAZE ADD 3 1/2" MAG NAIL RIGHT SIDE CENTER  
19" D. FIR S28°W 25.5 FT FULLY HEATED DOUBLE  
BLAZE ADD 3 1/2" MAG NAIL RIGHT SIDE  
CENTER

Monument Set (Procedure and Description)

MONUMENT DETAIL

Horizontal lines for Monument Set description.

New Accessories

Horizontal lines for New Accessories description.


Sketch of Monument, Accessories, and General Area

Location & Comments

mon on moderate N.W slope  
in old FIR Regrowth  
OCS Cottage Grove  
CANYONVILLE POSITION  
42° 46' 58.75785 N  
123° 42' 59.56353 W

COR IS APPROX  
150 FT EAST OF  
DIRT SPUR ROAD  
Comp. Decline. 14 1/2° E  
Agency DCSO  
Party Chief S. FRAUSE  
Note keeper  
Witnesses J. LORSONG

CS 67/60 - 50  
P923

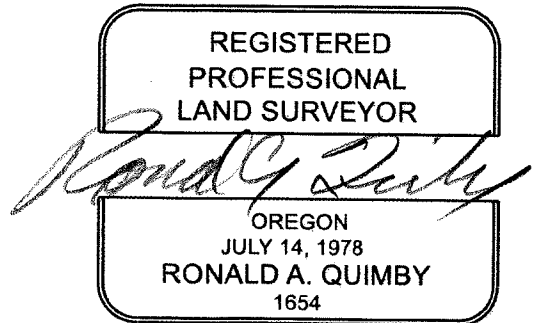

EXPIRES: 12/31/2026

PRIMARY CORNER DESCRIPTION Cor. Secs 13, 14, 23, & 24

*OKR'S CANYONVILLE COTTAGE GROVE POSITION*

Alias \_\_\_\_\_ Description 42°46'58.75785N

Alias \_\_\_\_\_ Description 123°42'59.50383W

Alias \_\_\_\_\_ Description \_\_\_\_\_

Alias \_\_\_\_\_ Description TRIMBLE GEO XT POSITION

42°46'58.710"N  
123°42'59.404"W

GLO Dependent survey by Fred Mensch & Gerald A. Sorrels, Dep. Surveyors under special instructions dated Dec. 22, 1916 - (DCSO records Vol. 21 Page(s) 8880)

Set an iron post, 3 ft. long, 2" dia., 24" in the ground, for cor. of secs. 13, 14, 23, & 24, with brass cap mkd

*2 1/2" B.C.* T32S R9W S 14 S 13 PROT 16"  
 S 23 S 24  
 1917

*ADD ROUGH MOUND OF STONE TO BASE*

- from which
- A fir, 36" dia., bears N.8°E., 127 lks., mkd: T32S R9W S13 BT. *83<sup>8</sup>*
  - A fir, 36" dia., bears S.78°E., 127 lks., mkd: T32S R9W S24 BT. *83<sup>8</sup>*
  - A fir, 48" dia., bears S.44°30'W., 239 lks., mkd: T32S R9W S23 BT. *157<sup>2</sup>*
  - A fir, 30" dia., bears N.51°W., 122 lks., mkd: T32S R9W S14 BT. *80<sup>5</sup>*

*DECLINATION 14 1/2° E* *RENEWED 6/19/25*

Douglas Co. Surveyors Office - John M. Powell - Frank Jones & J. Brady - June 1967 - C.S. File 54/44-15

Found - GLO Brass Cap, 1917, properly marked at corner.

- 30" x 2 FT ROTTED BROKEN SAWN STUMP* 36" D. Fir ✓ now stump, N.8°E. ✓ 83.8 ✓ ft., no scar *BLAZE GONE*
- 34" x 3 FT ROTTED SAWN STUMP* 36" D. Fir ✓ now stump, S.78°E ✓ 83.3 ✓ ft., scribe visible "9W" ✓
- 45" x 3 1/2 FT ROTTED SAWN STUMP* 48" D. Fir ✓ now stump, S.44 1/2° W ✓ 157.4 ft. shows good scar ✓ *NOT CHKD. TREES ON LINE*
- 40" - 30"*, now *37"* D. Fir ✓ N.51°W ✓ *80.5* ft. shows good scar. *82.5 TO MAG NAIL L.S.C.*
- New BTs *22"* 12" D. Fir ✓ N.19°W ✓ 15.0 ✓ ft. mkd. T32S R9W S14 CS BT. *FHDB*
- 11" 6"* D. Fir ✓ N.72°E ✓ 8.0 ✓ ft. mkd. T32S R9W S13 CS BT. "
- 17" 8"* D. Fir ✓ S.11°E ✓ 24.7 ✓ ft. mkd. T32S R9W S24 CS BT. "
- 19" 9"* D. Fir ✓ S.28°W ✓ 25.5 ✓ ft. mkd. T32S R9W S23 CS BT. "

*ADD A 3 1/2" MAG NAIL R.S.C. TO THE 4 "NEW" B.T.S*

*MON. ON MODERATE NW SLOPE IN OLD FIR REGROWTH  
 APPROX. 150 FT. EAST FROM DIRT SPUR ROAD.*

*CS 67/60-50*

*pg 3/3*