

GOVERNMENT CORNER RESTORATION FORM

FILED

TOWNSHIP 31S RANGE 3W SEC. 34 PLSS # 440/60

Date: 7/21/25 By: ke
This survey consists of:

DOUGLAS COUNTY OREGON

DATE 7-14-25

Map: _____
Narrative: _____
Corner Rpt: CS 67/100-56

Corner Designation

CN 1/16 S 34

DOUGLAS COUNTY
SURVEYOR

Monument(s) Found: (Condition and Source)

Condition report

Not Found

Renewed

Unrecorded

Surveyed In

1" Iron Pipe

Previous Renewals

Wenderoth DC 50 1948

C.S. 45/229

Quimby 2014 M166-15

MONUMENT DETAIL

Accessories Found

26" X 5 FT SAWN D. FIR STUMP N SIDE
25.3 FT (REC NSQE) Fully Healed Single
BLAZE ADD 3 1/2" MAG NAIL TOP CENTER

Metal Post 0.2 FT N.W

New Accessories

5/8" x 30" Iron Rod with DC30 plastic
 CAP N46W 59.3 FT set in westerly
 ROAD Shoulder proj. 4"

Sketch of Monument, Accessories, and General Area

Location & Comments

AREA CLEARCUT EXCEPT
 S.E. QUADRANT


MON 45' SOUTH
 AND 35' EAST OF
 GRAVE / ROAD JUST
 BEFORE SHARP TURN
 TO S.E. MON. ON
 MODERATE WEST
 SLOPE.

OCRS Cottage Grove
 Canyonville Position

Comp. Decline. 19 1/2° E
 Agency DC60
 Party Chief S.F. HAUSE
 Note keeper
 Witnesses J. LORSUM

42° 50' 18.41053 N
 123° 02' 33.20406 W

CS 67140-66 pg 2/3

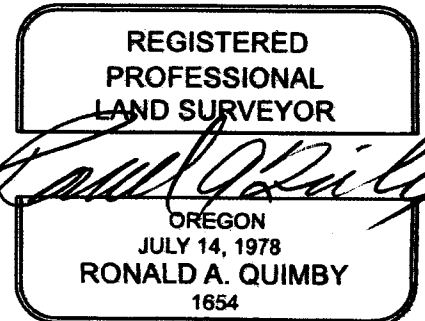

EXPIRES: 12/31/2026

M 166-13

OCCRS CANYONVILLE COTTAGE GROVE POSITION

① E 1/16 CORNER-SECTION 27/34
FOUND 1" IRON PIPE PER CS 45/229

42° 50' 18.41053" N
123° 02' 33.20406" W

BEARING OBJECTS:

14" HEMLOCK N3°E 27.5' HEALED FACE
20" HEMLOCK N72°E 19.1' HEALED FACE

CORS RENEWED 7/14/25
DECLINATION 14'14"E

② CN 1/16 CORNER-SECTION 34

FOUND 1" IRON PIPE PER CS 45/229 PROT 6"

BEARING OBJECTS:

26" x 5 FT SAWN STUMP. 28" FIR N4°E 25.3' SCRIBE BARELY VISIBLE FHSB ADD 3 1/2" MAG NAIL TOP CENTER
GONE FALLS IN NEW RD. - 16" MADRONE (DEAD) S29°W 57.0' HEALED FACE
FND. A STEEL LATH ~ 02 FT. NW

③ CE 1/16 CORNER-SECTION 34

FOUND 1" IRON PIPE PER CS 45/229

BEARING OBJECTS:

23" FIR N50°E 15.9' HEALED FACE

NEW BEARING OBJECT:

33" FIR S16°W 25.5' SCRIBED "CE 1/16 BT"

NEW REF:
A 5/8" x 30" i.r./PESD PROT. 4"
PLSTC CAP
SET IN WEST'LY RD SHOULDER N66°W 59'
MONUMENT ON MODERATELY STEEP
WEST SLOPE, 45 FT SOUTH AND 35 FT.
EAST OF GRAVEL RD JUST BEFORE
SHARP TURN TO SE.
ALL CLEAR CUT EXCEPT SE QUADRANT.

NARRATIVE
THE PURPOSE
MARK LINES
PROCEDURE
3 FT DIS
MONUMENTS
RECORDED
WERE TIED
SUBDIVIDED
SET AS SHK

④ S 1/16 CORNER-SECTION 34/35

FOUND 1" IRON PIPE PER CS 45/229 &
BRASS CAP PER M37-60

BEARING OBJECTS:

19" FIR N53°W 16.3' HEALED FACE
30" FIR N19°E 19.7' HEALED FACE
11" MADRONE N44°E 37.0'

FIELD CREW

⑤ C 1/4 CORNER-SECTION 34

FOUND 1" IRON PIPE PER CS 45/229

ORIGINAL BEARING OBJECTS PER CS 45/229
NO LONGER PRESENT

NEW BEARING OBJECTS:

7" PINE N11°E 2.3'
8" MADRONE S30°E 28.9'
8" PINE S13°W 20.3'
6" PINE N14°W 9.2'
ALL BT'S SCRIBED "C 1/4 S 34 BT"

OCCRS CANYONVILLE COTTAGE GROVE POS.
42° 50' 18.40922" N
123° 02' 15.47489" W

EQUIPMENT:

OFFICE:

DRAFTING:

460166

⑥ NE 1/16 CORNER-SECTION 34
NO ORIGINAL EVIDENCE OF CORNER FOUND

SET 5/8" x 30" IRON ROD w/ 2 1/2" VALUM. CAP STAMPED

NEW BEARING OBJECTS:

50" - 45" FIR S81°E 7.0' / USB ALL SCRIBING VISIBLE
15" - 12" FIR N68°W 21.1' FHSB ADD 3 1/2" MAG NAIL RSC TO BOTH B.T.S
BOTH SCRIBED "1/16 BT"
FND. STEEL LATH ~ 02 FT NORTH

⑦ N 1/16 CORNER-SECTION 34/35

FOUND 1" IRON PIPE PER PER CS 45/229

ORIGINAL BEARING OBJECTS PER CS 45/229

MONUMENT ON MOSTLY CLEAR CUT MODERATE
SW SLOPE
MONUMENT IS ~ 70 FT. SOUTH FROM
GRAVEL RD.



PROT. 5"