

TOWNSHIP 315 RANGE 3W SEC. 33 PLSS # 340200

Date: 7/24/25 By: ke
This survey consists of:

DOUGLAS COUNTY OREGON

DATE 7-21-25

Map: _____

Narrative: _____

Corner Rpt: CS 67160-58

Corner Designation

N 1/4 COR 533 ONLY

DOUGLAS COUNTY
SURVEYOR

Monument(s) Found: (Condition and Source)

2 1/2" ALUM CAP

___ Condition report

___ Not Found

Renewed

___ Unrecorded

___ Surveyed In

Previous Renewals

GRD SURVEY 1893 Vol 18 pg 7747
Roberts 1909 FIELD BOOK
10 pg 51
DCSO 1966 CS 54/20-37A
SEARCHES FOR NOT FOUND
Ruppert 1980 N779-29

MONUMENT DETAIL

T 315 R3W
1/4 ONLY
533
PLS 866
1980

Accessories Found

Very Rotted 32" X 2 1/2 FT D. FIR STUMP
N 47°30'E 47.5 FT

21" X 8 FT SAWN FIR STUMP S 14'43'E
75.4 FT

19" D. FIR S 46°W 8.2 FT

CARSONITE POST WITH NATIONAL
FOREST SIGN EAST 3.8 FT

Monument Set (Procedure and Description)

MONUMENT DETAIL

New Accessories

14" D. FIR S79 1/2° E 73 FT FULLY
Heated Double BLAZE MARKED BY
PERSONS UNKNOWN IN 2009 (INITIALS
LPG) ON TAG

Sketch of Monument, Accessories, and General Area

Location & Comments

OCRS Cottage Grove -
CANYONVILLE LOCATION

MON IS APPROX
250' S.W. OF
LOGGING LANDING
ON OLD E-W
CUT LINE


42° 50' 30. 73 779 N

123° 03' 43. 73 235 W

Comp. Decline. 14 1/4° E
Agency DCSO
Party Chief J. Larson
Note keeper
Witnesses S. F. HAUSE

CS 67160-68

pg 2/4

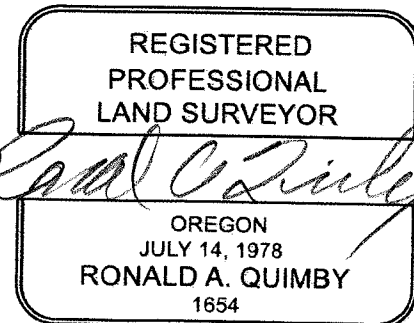

EXPIRES: 12/31/2026

7/21/25

TOWNSHIP 31 RANGE 03 POINT IDENTIFIER # 340200

PRIMARY CORNER DESCRIPTION N. 1/4 Cor. for Sec. 33 only

Alias _____	Description _____
Alias _____	Description _____
Alias _____	Description _____
Alias _____	Description _____

GLO survey by W.H. Byars, Deputy Surveyor, under Contract #152, dated June 3, 1871, - (DCSO records Vol. 18 Page(s) 7691-92)

Set 1/4 sec. post, from which
 A Laurel 5" dia., bears N.20°W., 24 lks. dist.
 A Pine 12" dia., bears S.30°E., 22 lks. dist.

GLO survey by William Bushey, Deputy Surveyor, under Contract #620, dated June 17, 1893 (DCSO records Vol. 18 Page(s) 7747)

The 1/4 sec. cor., which is a post, greatly decayed, marked 1/4 S on N. face, I find the 2 witness trees. I remove this post cor. and set a stone 15x10x5 ins., 10" in the ground, for 1/4 sec. cor. marked 1/4 on N. face; from which
 A Pine 12" dia., bears S.30°E., 22 lks. dist. mkd. 1/4 S BT.
 A Laurel 5" dia., bears N.20°W., 24 lks. dist. mkd. 1/4 S BT. This tree is dead. In its stead, I mark a:
 Fir 22" dia., which bears N.47 1/2°E., 72 lks. dist. 1/4 S BT.

C.E. Roberts - Sept. 20, 1909 - Field Book 10 Pg. 51

Set 1/4 sec. corner on North Bdy of section 33 as per original certified notes. Only one BT and it is cut off and destroyed. I put in two new BTs. in Section 28. No other trees in 33.
 A W.Fir 32" bears N.20°15'W., 168 lks.
 A Red Fir 30" dia., bears N.15°15'E., 144 1/2 lks.

Searched for, not fd by DCSO J.M.P., Feb. 1966 C.S. 54/20-37A

Survey by William Ruppert, LS #866 - For: U.S. Forest Service March 1980 - M 79-29

32" x 2 1/2 FT
 VERY ROTTEN

21" x 8 FT
 SAWN STUMP

-Found - 38" D.Fir stump bears N.47°30'E., 47.5 ft. "1/4" visible scribe on face.
 Set 2" x 30" alum. pipe with 2 1/2" magnetised cap marked T31S R3W 1/4 S33 PLS 866 1980.
 -New BTs- 18" D.Fir bears S.14°43'E., 75.4 ft., scribed "1/4 S33 BT".
 19"-7" D.Fir bears S.46°00'W., 8.3 ft. scribed "1/4 S33 BT".

This corner re-established from original bearing tree set in 1894 by Wm. Bushey.

(Cont. Next Page)

TOWNSHIP 31 RANGE 03 POINT IDENTIFIER # 340200

PRIMARY CORNER DESCRIPTION N. 1/4 Cor. for Sec. 33 only

Alias _____ Description _____

Alias _____ Description _____

Alias _____ Description _____

Alias _____ Description _____

Fd. and Used in BLM Resurvey by Boyd W. Peterson and Dale T. Bedell, Cadastral Surveyors, Under Group #'s 1277 & 1315, Surveyed Sept. 1985/August 1986 - (DCSO records Vol. 48 Page(s) 18326)

FOUND:

- CARSONITE POST W/ NATIONAL FOREST SIGN
EAST 3 $\frac{1}{2}$ FT.

- NEW 14" D. FIR, FHSB, $577\frac{10}{2}$ E, 7 $\frac{1}{2}$
MARKED IN 2009 BY INITIAL LPG

OGRS COTTAGE GROVE: $42^{\circ} 50'$ 30.73779 N
 $123^{\circ} 03'$ 43.73235" W

CORNER LIES APPROX. 250 FT SW
OF LOGGING LANDING ON OLD E/W
CUT LINE

CS 67140-58 pg 4/4

DECLINATION $14\frac{1}{2}^{\circ}$ E