

TOWNSHIP 315 RANGE 3W SEC. 28 PLSS # 342200

Date: 7/24/25 By: KL
This survey consists of:

DOUGLAS COUNTY OREGON

DATE 7-21-25

Map: _____
Narrative: _____
Corner Rpt: CS 67160-59

Corner Designation

SO 1/4 528 ONLY

DOUGLAS COUNTY
SURVEYOR

Monument(s) Found: (Condition and Source)

2 1/2" ALUM CAP FLUSH
WITH SURFACE

- Condition report
- Not Found
- Renewed
- Unrecorded
- Surveyed In

Previous Renewals

Ruppert 1980 M 79-29
CS 58/143 M
BLM 1985-1986 Vol 1
48 pg 18326

MONUMENT DETAIL

T315 R3W
1/4 528
ONLY
PLS 866
1980

Accessories Found

7" X 3" W. FIR STUMP N 45° 45' W 4.0 FT
16" W. FIR N 75° 35' E 21.8 FT (Rec 21.3')
CARBONITE POST WITH NATIONAL
FOREST SIGN EAST 4.0 FT

Monument Set (Procedure and Description)

MONUMENT DETAIL

New Accessories

9" D. FIR Fully Healed Single
BLAZE N 91/4° E 25.8 FT
MARKED IN 2009 by person
UNKNOWN (INITIALS LPG) ON TAG

Sketch of Monument, Accessories, and General Area


Location & Comments

OCS Cottage Grove
Canyonville Location

MON IS APPROX
100 FT SOUTHWEST
OF LOGGING
LANDING ON OLD
E-W CUT LINE

42° 50' 30.76534" N
123° 03' 41.71939 W

Comp. Decline. 1474° E
Agency DC60
Party Chief J. LORSUNG
Note keeper
Witnesses S. F. HUSE

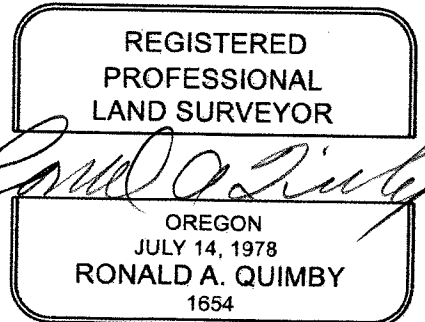

EXPIRES: 12/31/2026

CS 67/60-591 pg 2/3

7/21/25

TOWNSHIP 31 RANGE 03 POINT IDENTIFIER # 342200

PRIMARY CORNER DESCRIPTION So. 1/4 Cor. for Sec. 28 only

Alias _____	Description _____
Alias _____	Description _____
Alias _____	Description _____
Alias _____	Description _____

Survey by William J. Ruppert, LS #866 - For: U.S. Forest Service - Feb. 1980 - M 79-29 and C.S. File 58/143(n)

Set 2½" alum. cap on 2" x 30" alum. pipe, marked "T31S R3W 1/4 S28 only PLS 866 1980", from which

7" x 3 FT 9" W. Fir N.45°45'W., 4.0 ft. "¼ S28 BT".

16" x 8" W. Fir N.75°35'E., 21.8 ft. "¼ S28 BT".

Fd. and used in BLM Resurvey by Boyd W. Peterson and Dale T. Bedell, Cadastral Surveyors, Under Group #'s 1277 & 1315, Surveyed Sept. 1985/August 1986 - (DCSO records Vol. 48 Page(s) 18326)

FOUND:

- CARSONITE POST / NATIONAL FOREST SIGN EAST 4⁰ FT
- NEW 9" D. FIR, FHSB, N 9¼° E, 25⁸ MARKED IN 2009 BY INITIALS LP6

OGRS COTTAGE GROVE: 42° 50' 30.76534" N
123° 03' 41.71939" W

CAP IS NOW FLUSH WITH SURFACE, APPROX 100 FT SOUTHWEST OF LOGGING LANDING ON OLD E/W CUT LINE.