

GOVERNMENT CORNER RESTORATION FORM

FILED

TOWNSHIP 28S RANGE 6W SEC. 14

PLSS # 500940

Date: 8/11/2025 By: X  
This survey consists of:

DOUGLAS COUNTY OREGON

DATE 7-24-25

Map: \_\_\_\_\_  
Narrative: \_\_\_\_\_  
Corner Rpt: CS 67/61-4

Corner Designation

1/4 COR 15/14

DOUGLAS COUNTY  
SURVEYOR

Monument(s) Found: (Condition and Source)

DCSD BRASS CAP

- Condition report
- Not Found
- Renewed
- Unrecorded
- Surveyed In

Previous Renewals

- DCSD 1962 CS 49/139-21
- ARTMAN 1992 PP 1992-0026
- BENTZ 1995 M 122-57
- DEGroot 1998 P.P 1998-130 A-B

MONUMENT DETAIL

COUNTY SURVEYORS  
OFFICE  
1/4 S15/14  
1962

Accessories Found

38" X 3 FT OAK STUMP S78'14" W 131.3 FT  
Shows Good SCAR

42" B. OAK STUMP N55 1/2° W 198.0 FT

24 Laurel N49 1/2° W 159.8 FT

5/8" Iron Rod with Cap marked BTS  
N 45° E 19.0 FT

BTS NOT SPIKED DUE TO DISTANCE AND SLOPE

C.S. File 67/61-4

Monument Set (Procedure and Description)

MONUMENT DETAIL

New Accessories

4" X 8' FT METAL Post with SOLAR  
PANEL S87°E 7.9 FT

WOOD LATH 6" SOUTH

Sketch of Monument, Accessories, and General Area


Location & Comments

OCRS Cottage Grove  
CANYONVILLE LOCATION

Corner 15 12ft West of  
N-S and E-W fence intersection

43° 08' 03. 93151" N  
123° 28' 05. 05055" W

Comp. Decline. 14 1/2° E  
Agency DCSO  
Party Chief J LORSHUM  
Note keeper  
Witnesses

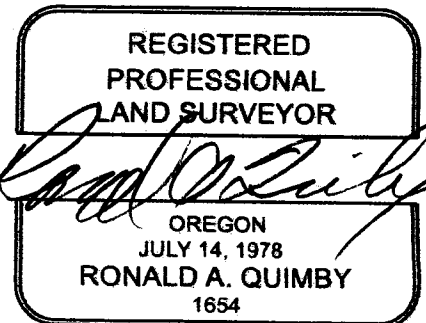

EXPIRES: 12/31/2026

CS 67/61-4  
2/3

TOWNSHIP 28 RANGE 06 POINT IDENTIFIER # 500440

PRIMARY CORNER DESCRIPTION 1/4 Cor for Secs 14 and 15

Alias _____	Description _____
Alias _____	Description _____
Alias _____	Description _____
Alias _____	Description _____

Original - Elder and Gile, under Contract #31 dated April 7, 1853 (DCSO records, Vol. 14 Page 5713)

Set 1/4 sec. post, from which  
A Y.Oak 18" dia., bears S.78 1/2°W., 199 lks.  
A Y.Oak 14" dia., bears N.55 1/2°W., 300 lks.  
No tree East of line.

*NOW 38" X 3 FT STUMP*  
Doug. County Surveyors Office - James W. Byron, Deputy - Dale McFarland; John Powell - Jan. 15, 1962 - C.S. File 49/139-21

Found - Orig. 18" now 44" B.Oak S.78 1/4°W., 131.3 ft., shows good scars. *42"*  
Orig. 14" now 40" B.Oak stump N.55 1/2°W., 198.0 ft.  
We open & find good scribing "B".

Set Brass cap at South side of anchor post mkd: County Surveyors Office 1962 1/4 S15|S14 T28S R6WW

(Cor. at intersection of N-S and E-W fences.) - *CORNER 12 FT WEST OF INTERSECTION*

New BTs - Rescribed O.B.T., now 44" B.Oak S.78 1/2°W., 131.3 ft.

*24"* 1/4 S15 Cs BT  
11" Laurel N.47 1/2°W., 159.8 ft. scribed 1/4 S15 CS BT.  
No trees near East of section line.

Fd. OK, James Artman, Feb. 1992, Partition 1992-0020  
Fd. Ok, D. Bentz, July 1995, M 122-57  
Fd. Ok, K. DeGroot, April 1998 - 1998-130 A&B

FOUND - 5/8" IR. W/CAP MARKED BTS

N 45° E, 19° FT

- 4" x 8 FT TALL METAL POST W/ SOLAR PANEL

S 87° E, 79 FT

- WOOD LATH SET 6" SOUTH

BT'S NOT SPIKED DUE TO DISTANCE + SLOPE

OGRS COTTAGE GROVE: 43° 08' 03.93151" N

DECLINATION: 14 1/4° E

123° 23' 05.05055" W

CS67/61-4 3/3