

GOVERNMENT CORNER RESTORATION FORM

TOWNSHIP 28S RANGE 7W SEC. 29 PLSS # 200200

FILED
Date: 8/11/2025 By: JC
This survey consists of:

DOUGLAS COUNTY OREGON

DATE 7-31-25

Map: _____
Narrative: _____
Corner Rpt: CS 67/61-6

Corner Designation

Sec Cor $\frac{30}{21} \frac{29}{32}$

DOUGLAS COUNTY
SURVEYOR

Monument(s) Found: (Condition and Source)

3/4" Iron pipe

- Condition report
- Not Found
- Renewed
- Unrecorded
- Surveyed In

Previous Renewals

Stewart 1/3 pg 126 CS 3/40-5/22
GLO Resurvey 1/01 14 pg 5884
DCSO 1956 CS 47/176 RM 1-15
Artman 1993 P.P. 1993-0024
DCSO 1994 CS 64/51-21
De Groot 1995 P.P. 1996-0004A&B

MONUMENT DETAIL

See Back

Accessories Found

Northwest corner of bottom concrete
step S3 1/2° E 25.05 FT (1956)
2 3/8" Brass cap N 39 1/2° W 18.0 FT down
3"
12" D. Fir N 4° W 25.4 FT (Rec 25.2 FT)
20" I. Cedar S 53° W 25.5 FT

C.S. File 67/61-6

RENEWALS

RENEWAL

MONUMENT DETAIL

Monument Set (Procedure and Description)

DCSO 2001 CS 64/19-43

De Groot 2004 M 145-29

Liang 2010 M 161-28

Hibbs 2012 M 164-18

New Accessories

5/8" x 30" Iron Rod N70°E 16.3 FT WITH DCSO plastic cap

Sketch of Monument, Accessories, and General Area

Location & Comments

DCRS Cottage Grove - Canyonville Zone Location

43°06'04.30568" N

123°33'40.54820 W


Comp. Decline. 14 1/4" E

Agency DCSO

Party Chief W. LORSONG

Note keeper

Witnesses

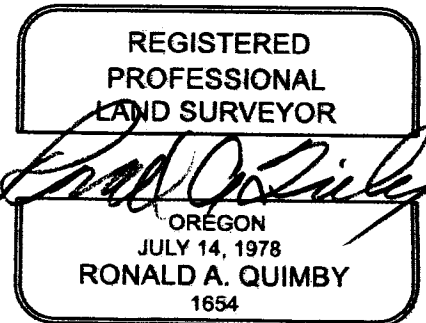

EXPIRES: 12/31/2026

CS 67/61-6
2/4

TOWNSHIP 28 RANGE 07 POINT IDENTIFIER # 200200

PRIMARY CORNER DESCRIPTION Sec. Cor. for 29, 30, 31 & 32

Alias _____	Description _____
Alias _____	Description _____
Alias _____	Description _____
Alias _____	Description _____

Original - Nathaniel Ford, under Contract #44 dated May 30, 1854 (DCSO records, Vol. 14 Page 5774)

Set a post, cor. of secs. 29, 30, 31 and 32, from which

- A B.Oak 24" dia., bears N.73°E., 24 lks. dist.
- A B.Oak 24" dia., bears S.5°W., 168 lks. dist.
- A B.Oak 18" dia., bears N.80°W., 27 lks. dist.
- A B.Oak 24" dia., bears S.30°E., 63 lks. dist.

G.G. Stewart, Deputy Co. Surveyor - Wit: C. Crocker; J.H. Porter - For: Bogard Real Estate - Sept. 1922 - Vol. 3 Pg. 126; C.S. Files 3/40 and 5/22

Renewed from O.B.T.s and one stump. Set Iron Pipe. Marked:

- W.Oak 30" dia., bears N.6°E., 26.3 ft.
- B.Oak 36" dia., bears N.19°W., 9.8 ft.
- B.Oak 36" dia., bears S.30°E., 39.8 ft.
- Pine 24" dia., bears S.46°W., 60.3 ft.

GLO resurvey by Mensch, 1924 (DCSO records, Vol. 14 Pg. 5884)

Intersect the cor. of secs. 29, 30, 31 and 32, which is a 1½" iron pipe, 1" above ground, set by county surveyor from which the original bearing trees:

- A B.Oak stump bears N.71°E., 26 lks. dist., (Not N.73°E., 24 lks.)
- A B.Oak 40" dia., bears S.30°E., 63 lks. dist.
- A B.Oak 40" dia., bears S.7°W., 120 lks. dist. (Not S.5°W., 168 lks.)
- A B.Oak 40" dia., bears N.76°W., 28 lks. (Not N.80°W., 27 lks.)

New Bearing Trees:

- A W.Oak 30" dia., bears N.6°E., 42 lks. mkd. T28S R7W S29 BT.
- A B.Oak 46" dia., bears S.30°E., 63 lks. dist., mkd. T28S R7W S32 BT.
- A Pine 35" dia., bears S.46°W., 93 lks. dist., mkd. T28S R7W S31 BT.
- A B.Oak 40" dia., bears N.19°W., 17 lks. dist., mkd. T28S R7W S30 BT.

Doug. County Surveyors Office - James Byron, Deputy - April 1956 - C.S. File 47/176; RM 1415

Found - 3/4" Iron pipe at corner.

SOME / 44" B.Oak N.76°W., 18.8 ft., to center of tree.

 \ 42" B.Oak, stump, N.19°W., 11.0ft. to center of stump

(Cont. Next Page)

CS 67/61-6

