

GOVERNMENT CORNER RESTORATION FORM

FILED

TOWNSHIP 22S RANGE 12W SEC. 5 PLSS # 240600

Date: 9-22-25 By: KE  
This survey consists of:

DOUGLAS COUNTY OREGON

DATE 9-4-25

Map: \_\_\_\_\_

Narrative: \_\_\_\_\_

Corner Rpt: CS 67161-21

Corner Designation

1/4 COR SS  
EB

DOUGLAS COUNTY  
SURVEYOR

Monument(s) Found: (Condition and Source)

2 1/2" BRASS CAP ON  
IRON PIPE PROJ. 2"

Condition report

Not Found

Renewed

Unrecorded

Surveyed In

Previous Renewals

Set By Hixtz 1983 M 94-34  
Roberts 1989 CS 63/46-7 (G)  
BENTLEY 1995 M 123-4

MONUMENT DETAIL

PLS 497

1/4 SS  
EB

1983

T25S R12W

Accessories Found

Very Rotted 22" X 3 FT <sup>SPRUCE</sup> STUMP N151°30'E  
11.8 FT Rotted BLAZE - SCAR

Very Rotted 18" X 4 1/2 FT FIR STUMP  
S81°E 24.1 FT BLAZE Mostly Rotted  
PARTIAL Scribes SB B7 visible Spike  
NAIL Left Side Center

New Accessories

4" Hemlock N65°E 8.6 FT Scribed X BT  
 ON Double BLAZE

12" D. Fir S20°E 3.5 FT scribed  
 1/4 SB BT ON Double BLAZE

10" D. Fir S 74°W 7.5 FT Scribed 1/4 SB BT  
 ON Double BLAZE

11" D. Fir N17 1/2°W 10.3 FT Scribed 1/4 SE BT  
 ON Double BLAZE

Sketch of Monument, Accessories, and General Area

Location & Comments


OCRS Cottage Grove -  
 Canyonville zone location

MON IN ODER  
 REPRD NEAR TOP  
 OF MODERATE EAST  
 SLOPE APPROX 150  
 FT N/E OF  
 SHORT LOGGING  
 SPUR  
 Comp. Decline. 14 1/2° E  
 Agency DCSO  
 Party Chief S. F. HAUSE  
 Note keeper  
 Witnesses J. Larsung

43°40'57.35866" N  
 124°09'15.45486" W

CS 67161-21

pg 2/3

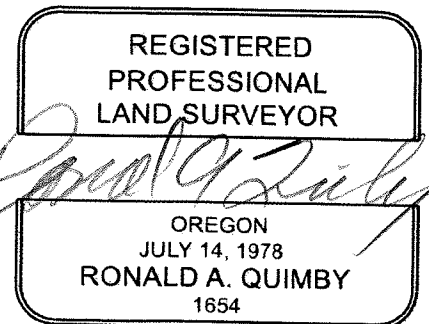

EXPIRES: 12/31/2026

PRIMARY CORNER DESCRIPTION 1/4 Cor. for Secs. 5 and 8

3?

Alias _____	Description _____
Alias _____	Description <u>DCRS CANYONVILLE COTTAGE GROVE POSITION</u>
Alias _____	Description _____
Alias _____	Description <u>43° 40' 57.35866"</u>
	<u>124° 09' 15.45486"</u>

GLO survey by Harvey Gordon Deputy Surveyor, under Contract #69 dated Feb. 2, 1857 (DCSO records Vol. 5 Page(s) 2000)

Set 1/4 sec. post, from which  
 A Spruce 30" dia., bears S.74 1/2° E., 20 lks. dist.  
 A Spruce 10" dia., bears N.4 1/2° W., 34 lks. dist.

DECLINATION 14 1/2° E RENEWED 9/4/25

Survey by Richard Hintz - For: Douglas County Land Dept. - May 1983 - C.S. File 58/140 and M 94-34

Set 1 1/4" x 36" I.P. with stamped brass cap "PLS 497" SEE BELOW  
 New BTs -18" Spruce bears N.51°30'E, 11.8 ft. scribed. ROTTED BLZ, SCAR  
 -22" Fir bears S.21°00'E, 24.1 ft. scribed. MOST OF BLZ, ROTTED  
18" x 4 1/2 FT. STUMP THIS STUMP HAS SPIKE NAIL L.S.C. PARTIAL SCRIBE "58 BT" VIS.

Fd. OK, Jan. 23, 1989 by Les Roberts - C.S. File 63/46-7(G)  
Fd. Ok by John Bentley, Oct. 1995 - M 123-4

2 1/2 BC STAMPED " PLS 497" MON. PROT. 2"  
 1/4 55  
 58  
 1983  
 T22S R12W  
 AN ALUMINUM POST  
 PROT 1.5 FT. FOUND NORTH, 1 1/2 FT.

NEW REF. 5

- 4" HEMLOCK SCRIBED "X" "BT" ON HIGH-LOW BLAZE; BEARS N65°E, 8 1/2 FT. DIST.
- 12" D. FIR SCRIBED "1/4 58" "BT" ON A DOUBLE BLAZE; BEARS S20°E, 3 1/2 FT. DIST.
- 10" D. FIR SCRIBED "1/4 58" "BT" " " " " ; BEARS S74°W, 7 1/2 FT. DIST.
- 11" D. FIR SCRIBED "1/4 55" "BT" " " " " ; BEARS N17 1/2°W, 10 3/4 FT. DIST.

MONUMENT IN OLDER REPROD NEAR TOP OF MODERATE EAST SLOPE  
APPROX. 150 FT. NNE OF SHORT LOGGING RD. SPUR.

MINI G-5  
43.68260  
124.15436

VERY ROTTED  
22" x 3 FT STUMP  
VERY ROTTED