

TOWNSHIP 26S RANGE 2W SEC. 14

PLSS # 500400 Date: 9-24-25 By: KL
This survey consists of:

DOUGLAS COUNTY OREGON

DATE 7-10-25

Map: _____

Narrative: _____

Corner Rpt: CS 67/101-25

Corner Designation

DOUGLAS COUNTY
SURVEYOR

Monument(s) Found: (Condition and Source)

___ Condition report

___ Not Found

Renewed

___ Unrecorded

___ Surveyed In

DCSO BRASS CAP Along
Side GRANITE Stone 6" x 10' x 15"
with 2 notches & 3 notches

Previous Renewals

GLO Survey 1908 Vol 10 pg 4229

GLO Survey 1916-1918 Vol 10 pg 4305

BLM Resurvey 1959 Vol 10 pg 12724-25

BLM Resurvey 1975 Vol 46 pg 15724-5

DCSO 2004 CS 67/13-6

MONUMENT DETAIL

DOUGLAS COUNTY
SURVEYOR
T26S R2W
S15/S14
S22/S23
2004

Accessories Found

BURNED-DEAD Solid 28" D. FIR S71 1/2 W 34.7'
17" FIR Singed base N51 1/2 E 42.9 FT

Healed Single BLAZE

BURNED-DEAD- Solid 30" FIR N70 1/2 W 48.6 FT

(Rec 49.5 FT) Healed Single BLAZE

16" Cedar Singed base S1 1/2 E 128.4 FT

Healed double BLAZE

BURNED 20" D. FIR Few live Limbs

S35 W 44.2 FT Healed Single BLAZE

Add 3 1/2" MAG Nail Right Side Center
at 2004 Dist To All BTS Except
S.E. Cedar

Monument Set (Procedure and Description)

MONUMENT DETAIL

Horizontal lines for Monument Set description.

New Accessories

Horizontal lines for New Accessories description.

Sketch of Monument, Accessories, and General Area


Location & Comments

Trimble Geo XT Position
43°17'57.109" N
122°54'47.945" W

AREA BURN
9-2020

Comp. Decline. 14 1/2° E
Agency DCSO
Party Chief S. Fause
Note keeper
Witnesses J. Lorsung

CS 67161-25 pg 2/4

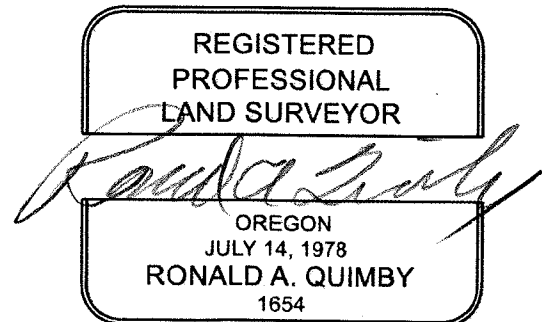

EXPIRES: 12/31/2026

TOWNSHIP 26 RANGE 02 POINT IDENTIFIER # 500400

PRIMARY CORNER DESCRIPTION Cor Secs 14, 15, 22, & 23

Alias _____	Description _____
Alias _____	Description <u>TRIMBLE GEO XT POSITION</u>
Alias _____	Description _____
Alias _____	Description <u>43°17'57.109" N</u> <u>122°54'47.945" W</u>

Fd. cap 4/13/1992 BLM C.S. File 63/140-9

RENEWED 7/10/25

Douglas Co. Surveyors Office - Stephen J. Flause - John Pike
- 1/6/2004 - C.S. File 67/13-6

Found - A granite stone measuring approx. 6x10x15" with 2 notches & 3 notches marked on the appropriate faces (1909 Gibb resurvey) is fd loose, & out of position, on ground surface. Stone is near a hole with dimensions similar to base of stone. 1957 DCSO brass cap not fd.

Accessories fd bearings & dists are measured from westerly edge of fd hole; most fd evidence indicates this was the set position for the 1957 brass cap from which the DCSO & 1959 BLM bearings & distances were measured. The fd. evidence also indicates the center of the fd. stone when properly oriented in the above fd hole is the corner position established in 1909 by Gibb.

BURNED DEAD 28" SOLID TREE

One orig. BT fd., A ~~12"~~ *27"* fir now a *27"* DBH D. Fir with fully healed single blaze bears S.71½°W, 34.1' dist. (rec. S.70°W. 35.6') Possible root hole of NW OBT fd no other orig evidence remains.

From the 1916 Mensch resurvey 3 renewal BTs are fd (Following 3 bearings & distances noted as record would be to center of 1909 stone monument)

SINGED BASE ALIVE 17"

A ~~12"~~ *16"* Fir now *16"* DBH D. Fir with fully healed single blaze bears N.51½°E, 42.9' (rec N.51½°E. 42.2')

GONE BURNED AWAY

~~5" Laurel now a rotted broken Madrone stump (good root position) with no discernible scribing bears S.34°W., 15.5' (rec. S.33°W., 16.5')~~

BURNED DEAD 30" SOLID TREE

~~18"~~ *28"* Fir now *28"* DBH D. Fir with a fully healed single blaze bears N.70½°W, ~~49.5'~~ *48.6'* (rec. N.71°W., 48.8')

SINGED BASE ALIVE

From the 1957 DCSO renewal 1 renewal BT is fd: *16"* Cedar, now a *16"* Incense Cedar with a fully healed double blaze bears S.1½°E, 128.4' (rec. S.1°E., 128.4')

BURNED A FEW LIVE LIMBS 20"

A BT of unknown origin: *17"* DBH D. Fir with an apparent fully healed single blaze (we do not open) bears S.35°W, 44.2' (rec. on fd. BT tag has erroneous reverse bearing S.35°W, and a dist. of 67 lks; survey attributed to "P.O.P.")

New - The previously described fd. stone is set in the fd. hole with 2 notches on one side facing east & 3 notches on another side facing south.

continued next page

ADD NAIL AT 2004 DIST. R.S.C. TO ALL B.T.S EXCEPT SE CEDAR. 3

TOWNSHIP 26 RANGE 02 POINT IDENTIFIER # 500400

PRIMARY CORNER DESCRIPTION Cor. Secs. 14, 15, 22, & 23

Alias _____ Description _____
Alias _____ Description _____
Alias _____ Description _____
Alias _____ Description _____

Along the west edge of the above stone is set a 2 3/8" brass cap on a 30" galvanized iron pipe. The stone is set with its top flush with the ground & the brass cap monument protrudes approx 6" above the ground. Cap mkd:

DOUGLAS COUNTY SURVEYOR

T26S R2W

S 15 | S 14

S 22 | S 23

2004

ALL AS DESCRIBED

Note - No new accessories
Monument is on gradual southerly facing forested slope. ✓
Compass decl. 16 3/4° E.

*NOW
PARTIALLY
BURNED*

CAP BROKEN OFF

NEEDS FULL RESET

(CAP WAS OK)

MPJ

CS 67161-25 pg 4/4