

GOVERNMENT CORNER RESTORATION FORM

FILED

TOWNSHIP 25S RANGE 2W SEC. 33 PLSS # 340100

Date: 9/24/25 By: KE
This survey consists of:

DOUGLAS COUNTY OREGON

DATE 9-23-25

Map: _____
Narrative: _____
Corner Rpt: CS 67101-27

Corner Designation

5/4 S33 only

DOUGLAS COUNTY
SURVEYOR

Monument(s) Found: (Condition and Source)

3/4" BLM BRASS CAP
ON 2" I.D. IRON PIPE
proj 8"

Previous Renewals

BLM RESURVEY 2018-2020
Vol 59 pg 23915
Quimby 2020 CS 45/106-54

- Condition report
- Not Found
- Renewed
- Unrecorded
- Surveyed In

MONUMENT DETAIL

T25S R2W
1/4 S33
T26S
2018

Accessories Found

15" Burnt D. Fir N43°E 7.0 FT (REC 6.8 FT)
partial scribe 1/4 on partly Healed
Single BLAZE

14" Burnt D. Fir N60°W 7.6 FT (REC 7.9 FT)
Scribes 1/4 S33 BT visible on partly Healed
Single BLAZE

3 Iron Rods with 1 engineering
Plastic caps

N 63°E 4.2 FT proj 6"

S 49°W 8.0 FT proj 3"

N 46°W 5.5 FT proj 2"

Alum posts 0.3 FT West AND 0.2 FT EAST
OF BRASS CAP

Monument Set (Procedure and Description)

MONUMENT DETAIL

Blank lines for Monument Set description

New Accessories

Blank lines for New Accessories description

Sketch of Monument, Accessories, and General Area

Location & Comments


DCRS Cottage Grove To
Canyonville Zone Location
43°20'37.83854 N
123°56'35.31764 W

MON ON moderate
East Slope Burnt
Timber North
Burnt Recent
Clearcut South

Comp. Decline. 14 1/4° E
Agency DCSO
Party Chief S. F. Hulse
Note keeper
Witnesses J. Loring

CS 67/61-27

pg 2/3

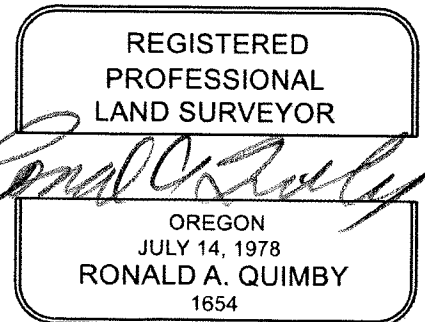

EXPIRES: 12/31/2026

TOWNSHIP 25 RANGE 02 POINT IDENTIFIER # 340100

PRIMARY CORNER DESCRIPTION South 1/4 Sec 33 only

Alias _____	Description _____
Alias _____	Description <u>OCRS CANYONVILLE COTTAGE GROVE POSITION</u>
Alias _____	Description _____
Alias _____	Description <u>43° 20' 37.83854" N</u>
	<u>122° 56' 35.31764" W</u>

BLM dependent resurvey by Jeffrey O. Covington, Cadastral Surveyor, under Group No. 2919, surveyed May 2018/July 2020 Approved 3/2021 - (DCSO records Vol. 59 Page(s) 23913)

Point for the 1/4 sec. cor. of sec. 33 only, on the S. bdy. of T25S R2W.
Set a stainless steel post, 28 ins. long, 2 1/2" dia., 24" in the ground, with brass cap mkd. T25S R2W
1/4 S 33
T26S
2018

from which
A fir, 14" dia., bears N.43 1/2° E., 6.8 ft., mkd. 1/4 S33 BT.
A fir, 13" dia., bears N.59 3/4° W., 7.9 ft., mkd. X BT.
Each new BT has a 2 1/2" x 1/4" magnetic nail (Mag Nail) driven at the base right side-center & each monument established or remonumented has a magnet deposited in a white plastic case at the base of the stainless steel post. Alum. Angle iron driven alongside each monument.

DECLINATION 14° 14' E RENEWED 9/23/25
Ron Quimby - Crew: N. Fromdahl, L. Heddens & J. Ogden - 10/2020 - C.S. File 65/106-54

Found - BLM brass cap (not approved yet) cap mkd:
US DEPARTMENT OF THE INTERIOR
3 1/4" B.C. T25S R2W 1/4 S33 ✓ PROT 8" FOUND TWO ALUMINUM LATHS
ON 2" I.D.I.P. T26S 2018 ONE 03' WEST, ONE 02' EAST

BUR. OF LAND MANAGEMENT, PARTIAL
15" 14" burnt Fir N.43° E, 6.8 ft. 70 illegible scribes "1/4" PHSB
14" burnt Fir N.60° W, 7.9 ft. 76 illegible scribes "1/4" S33 BT " PHSB
New - 5/8" x 30" I. Rod with yellow plastic cap stamped "ie ENGINEERING" post along side.
3 I.R.s FOUND
~~S. 80° E., 7.5'; S. 6° E., 7.2'; S. 45° W., 6.4'~~ WRONG NOTES?
Note - Area badly burnt 9/2020
Compass decl. ~~15 1/2° E~~ NOW 14 1/4° E

THE 3 I.R.s ARE FOUND AS FOLLOWS
N 63° E, 42 FT. DISTANT, SET PROT. 6"
S 49° W, 80 FT. DISTANT, SET PROT. 3"
N 46° W, 55 FT. DISTANT, SET PROT. 2"
ON MODERATE EAST SLOPE BURNED STANDING TIMBER NORTH
BURNED RECENT CLEARCUT SOUTH.

CSL 07/01-27 093/3