

GOVERNMENT CORNER RESTORATION FORM

FILED

TOWNSHIP 24S RANGE 3W SEC. 24 PLSS # 640300

Date: 10/20/25 By: KL
This survey consists of:

DOUGLAS COUNTY OREGON

DATE 10-4-25

Map: _____

Narrative: _____

Corner Rpt: CS 107/101-32

Corner Designation

$\frac{1}{4}$ 524
525

DOUGLAS COUNTY
SURVEYOR

Monument(s) Found: (Condition and Source)

None

Condition report

Not Found

Renewed

Unrecorded

Surveyed In

Previous Renewals

Weyerhaeuser Donald

Jordan

DCSB - Reported as
Not Found

MONUMENT DETAIL

Accessories Found

Monument Set (Procedure and Description)


MONUMENT DETAIL

New Accessories

Sketch of Monument, Accessories, and General Area


Location & Comments

Comp. Decline. _____
 Agency DC60
 Party Chief S. F. AUSE
 Note keeper _____
 Witnesses J. Lorusz

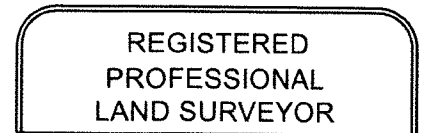

CS 47/41-32

pg 2/3

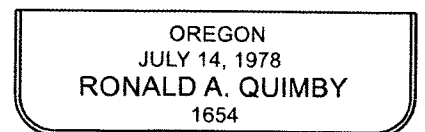

EXPIRES: 12/31/2026

TOWNSHIP 24 RANGE 03 POINT IDENTIFIER # 640300

PRIMARY CORNER DESCRIPTION 1/4 Cor. Secs. 24 & 25

Alias _____ Description _____
Alias _____ Description _____
Alias _____ Description _____
Alias _____ Description _____

GLO survey by L.H. Wheeler under Contract No. 467 dated April 7, 1883 (DCSO records Vol. 7 Page(s) 2975)

Set cedar post 3 ft. long, 3" sq., 24" in the ground for 1/4 sec. cor. marked 1/4 sec. cor. mkd. 1/4 S on N face from which
A fir, 24" dia., bears N.25°E., 33 lks., mkd: 1/4 S BT.
A fir, 36" dia., bears S.60°E., 25 lks., mkd: 1/4 S BT.

Weyerhaeuser Co., Donald Jordan Surveyor - Dec. 1965 - C.S. File 53/111-34

Found - 24" Fir, now 28", face not cut out but face line visible on top of stump.
36" Fir S.60°E., 16.5 ft., now fir stub, 10' high, face not grown, scribing visible. (This information placed on the orig. BTs by the 1944 Weyerhaeuser Co. survey didn't agree with the orig. 1883 survey. I accepted the orig. BTs disregarded the 1944 data & set the corner on the basis of the orig. "call" distances)
Set - 1"x30" alum. pipe, from which
Orig. 28" Fir stump N.32°E., 21.8 ft. "W" nail & plate.
Orig. 36" Fir stub S.64°E. 16.5 ft. "W" nail & plate
Logged 1963.

Douglas Co. Surveyors Office - Vernon "Ray" Tracy - March 1968 - C.S. File 54/27-151

Reported as not found
Apparently destroyed by new log road & landing.

NOT FOUND, SEARCHED FOR WITH GPS
TIE. NO EVIDENCE FOUND.

CS 67111-32 pg 3/3