

TOWNSHIP 26S RANGE 3W SEC. 12

PLSS # 640500 Date: 11/12/25 By: KC

This survey consists of:

DOUGLAS COUNTY OREGON

DATE 10-27-25

Map: _____

Narrative: _____

Corner Rpt: CS 67/61-35

Corner Designation

1/4 COR S12
S13

DOUGLAS COUNTY
SURVEYOR

Monument(s) Found: (Condition and Source)

DCSO BRASS CAP ON
1 1/4" Iron pipe Proj
8"

___ Condition report

___ Not Found

Renewed

___ Unrecorded

___ Surveyed In

Previous Renewals

DCSO 1966 CS 54/7-45
DCSO 1977 CS 59/42-37
DCSO 2007 CS 67/24-48
BLM Resurvey 2019 Vol
59 pgs 23986-23988

MONUMENT DETAIL

COUNTY SURVEYORS
OFFICE
T26S

1/4 S12
S13
RBW
1966

Accessories Found

49" X 2 FT FIR STUMP N152°E 31.0 FT
SAWN & Burnt Add 3 1/2" MAG NAIL TOP
Center Healed BLAZE

72" TIN CAPPED SUGAR PINE STUMP S20°E
21.1 FT under pile of Blow down

Burned 9" X 20 FT FIR SNA9 S26 1/4 W 9.2 FT
Healed BLAZE ADD 3 1/2" MAG NAIL RIGHT
Side Center

26" X 8 FT FIR N30 1/2° W 14.0 FT Healed
BLAZE ADD 3 1/2" MAG NAIL RIGHT Side
Center

31" BURNED FIR S49 1/4° W 19.5 FT Healed
BLAZE MAG NAIL RIGHT Side Center

Alum. Angle Iron's 0.5 FT East & West

Monument Set (Procedure and Description)

MONUMENT DETAIL

Horizontal lines for Monument Set description.

New Accessories

Horizontal lines for New Accessories description.

Sketch of Monument, Accessories, and General Area

Location & Comments

OCRS COORDINAT SYSTEM
Cottage Grove - Canyonville
Zone

MON APPROX 450 FT
SOUTH OF ACCESS ROAD
ENTER ON LARGE
BENCH IN E-W CUT
LINE

N 175773.829

E 252331.293

AREA BURST
9/2020

Comp. Decline. 14' 14" E

Agency DCSD


Party Chief J. LOSUNA

Note keeper


Witnesses

CS 67161-35

pg 2/4

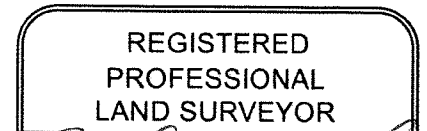

Ronald A. Quimby

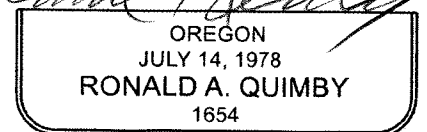

EXPIRES: 12/31/2026

TOWNSHIP 26 RANGE 03 POINT IDENTIFIER # 640500

PRIMARY CORNER DESCRIPTION 1/4 cor. Secs. 12 & 13

Alias _____	Description _____
Alias _____	Description _____
Alias _____	Description _____
Alias _____	Description _____

BURNED 9" x 20"
26" x 8"
31" BURNED
STANDING

A fir snag, 9" dia., bears S.26 $\frac{1}{4}$ °W., 9.3 ft., with a healed blaze.
A fir, 24" dia., bears N.30 $\frac{1}{4}$ °W., 16.0 ft., with a healed blaze.
and a new bearing tree
A fir, 26" dia., bears S.49 $\frac{1}{2}$ °W., 18.5 ft., mkd. $\frac{1}{4}$ S13 BT.
Each new BT has a 2 $\frac{1}{2}$ " x $\frac{1}{4}$ " magnetic nail (Mag Nail) driven at the base right side-center & each monument established or remonumented has a magnet deposited in a white plastic case at the base of the stainless steel post. Alum. Angle iron driven alongside each monument.

ONE EAST, ONE WEST .5 FT

OCRS COTTAGE GROVE CANYONVILLE:

N 175773.829 , E 252331.293

CORNER FALLS Approx. 450 FT SOUTH OF ACCESS RD. INTERSECTION IN AN EAST-WEST CUT LINE ON A LARGE BENCH.

ALL REFERENCES TAGGED + SIDE SPIKE RIGHT SIDE CENTER UNLESS NOTED OTHERWISE.