

GOVERNMENT CORNER RESTORATION FORM

FILED

TOWNSHIP 25S RANGE 2W SEC. 4 PLSS # 360700

Date: 12/10/25 By: ICE
This survey consists of:

DOUGLAS COUNTY OREGON

DATE 11-26-25

Map: _____

Narrative: _____

Corner Rpt: CS 67/61-43

Corner Designation

N.W COR TRACT 37

DOUGLAS COUNTY
SURVEYOR

Monument(s) Found: (Condition and Source)

3 1/4" BLM BRASS CAP
PROJ 13" ADD ROUGH MOUND
OF STONE

___ Condition report

___ Not Found

Renewed

___ Unrecorded

___ Surveyed In

Previous Renewals

BLM RESURVEY 1943
Vol 32 pg 13280

MONUMENT DETAIL

T24S R2W
S33
TR 37

S4 | TR37
T25S R2W
1963

Accessories Found

BURNED ROTTED HOLLOW 30" X 9 FT CEDAR
S 82 1/4° E 60.7 FT (REC 92 LKS)
BLAZE BURNED AWAY (NOTE B & D NOT
CHECKED DUE TO DEBRIS ON LINE

New Accessories

12" X 1 FT Fir Stump N16°W 18.4 FT
3 1/2" MAG Nail Top Center

8" X 1 FT Hemlock Stump S22°W 18.2 FT
3 1/2" MAG Nail Top Center

Sketch of Monument, Accessories, and General Area

Location & Comments


MGN 15 APPROX 120 FT
SOUTH OF GRAVEL ROAD
BURNED OLD TREES S.E
QUAD REST CLEAR CUT

AREA BADLY
BURNT
9/2020

TRIMBLE GEO XT POSITION
43° 43392245 N
122° 93721174 W

Comp. Decline. 14 1/4° E
Agency DCSO
Party Chief S.F. HAUSE
Note keeper
Witnesses J. LORSUNG

CS 67141-43 pg 2/3

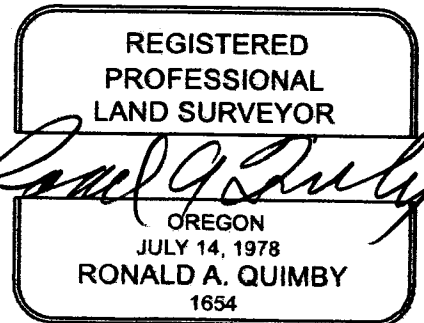

EXPIRES: 12/31/2026

County Surveyor's Record, Douglas County, Oregon

Dependent Resurvey, South Boundary, T. 24 S., R. 2 W.

MINI GIS
43.43392
122.93723

CHAINS

- A cedar, 20 ins. diam, bears N. 40° E., 39 lks. dist., mkd. T24S R2W S34 BT. (1951 bearing tree.)
- A hemlock, 6 ins. diam., bears S. 32° E., 53 lks. dist., mkd. T25S R2W S3 BT. (1963 bearing tree.)
- A chinquapin, 16 ins. diam., bears S. 64¼° W., 33 lks. dist., mkd. T25S R2W S4 BT. (1963 bearing tree.)
- A fir, 26 ins. diam., bears N. 46½° W., 69 lks. dist., mkd. T24S R2W S33 BT. (1951 bearing tree.)

Land, mountainous.
Soil, rocky clay loam.
Timber, fir, hemlock, sugar pine, cedar, maple, yew, and madrone; undergrowth, vine maple, salal, huckleberry, and Oregon grape.

S. 80° 35' W., bet., secs. 4 and 33.

Descend 100 ft. over SW. slope, through heavy timber and dense undergrowth.

2.90 Creek, 10 lks. wide, course S. 15° E.; asc. 225 ft. over SE. slope.

10.00 Spur, slopes S. 15° E.; desc. 125 ft. over SW. slope.

17.30 Foot of descent, slopes SW.; asc. 20 ft. over SE. slope.

18.30 Top of ascent, slopes S.; desc. slightly along S. slope

18.90 Point for the NW cor. of Tract No. 37, in sec. 4, T. 25 S., R. 2 W.

DECLINATION 14¼° E RENEWED 11/26/25
Set an iron post, 28 ins. long, 2½ ins. dia., 22 ins. in the ground, with brass cap mkd.

TRIMBLE GEO XT POSITION
43.43392245° N
122.93721174° W

T 24 S R 2 W 3¼" BC, PROT 13"
S 33
TR 37
S 4 | TR 37 ✓
T 25 S | R 2 W
1963
ADD ROUGH MOUND OF STONE AROUND MONUMENT

from which

GONE NO EVIDENCE - A hemlock, 12 ins. diam., bears N. 7° W., 29 lks. dist., mkd. TR37 S33 BT. 1914

BURNED ROTTEN HOLLOW 30" x 9" A cedar, 30 ins. diam., bears S. 82½° E., 92 lks. dist., mkd. TR37 S4 BT. BLAZE BURNED AWAY 6072

Descend 120 ft. along S. slope, changing to SW. slope. DEBRIS, BUT ROUGH DIST. CHECK GOOD

27.00 Creek, 30 lks. wide, course S. 20° E.; asc. 38 ft. over SE. slope.

37.81 Point for the ¼ sec. cor. of sec. 33, at proportionate distance; there is no remaining evidence of the original corner. This now becomes the ¼ sec. cor. of secs. 4 and 33.

MONUMENT 15 APPROX 120 FT SOUTH FROM GRAVEL RD, BURNED OLD TREES SE QUADRANT SET AN IRON POST, 36 ins. long, 1 in. diam., 28 ins. in the ground, with brass cap mkd. REST CLEAR CUT

12" x 1 FT. FIR STUMP 1/2 MAG NAIL SET TOP CENTER 18¼° N16° W
8" x 1 FT. HEMLOCK STUMP " CS 1110143 182° S22° W