

TOWNSHIP 24S RANGE 2W SEC. 33 PLSS # 400140

Date: 12/10/25 By: ke  
This survey consists of:

DOUGLAS COUNTY OREGON

DATE 12-2-25

Map: \_\_\_\_\_  
Narrative: \_\_\_\_\_  
Corner Rpt: CS 67/111-44

Corner Designation

1/4 COR 33/34

DOUGLAS COUNTY  
SURVEYOR

Monument(s) Found: (Condition and Source)

2 1/2" BLM BRASS CAP  
PROJ 6"

- Condition report
- Not Found
- Renewed
- Unrecorded
- Surveyed In

Previous Renewals

BLM RESURVEY 1951-1943  
Vol 132 pgs 13295-6  
DCSO 2008 CS 67/25-52  
Quimby 2015 CS 65/89-3

MONUMENT DETAIL

1/4  
533 | 534  
1951

Accessories Found

BURNED - DEAD 9" CHINCAPIW N70°E 27.0 FT  
BLAZE BURNED OUT  
Burned Rotted 8 1/2" X 1 1/2 FT D. FIR STUMP  
S75°E 20.0 FT Scribe 3 AND Notch  
Visible

Burned - DEAD 20" D. FIR S98°W 18.4 FT  
Fully Healed Double BLAZE ADD 3 1/2" MAG  
NAIL Left side Center

Burned DEAD 33" D. FIR N70°W 7.3 FT  
Healed FACE  
26" X 1 FT D. FIR STUMP S89°E 36.3 FT  
Mostly Gone

Add 3 1/2" MAG NAIL RIGHT Side Center  
To CHINGUAPIW AND N.W. FIR BT

Monument Set (Procedure and Description)

MONUMENT DETAIL

New Accessories

BURNED - DEAD 40" D. FIR N30°W 15' FT  
3/8" MAG NAIL RIGHT SIDE CENTER

Sketch of Monument, Accessories, and General Area


Location & Comments

TRIMBLE 6EDXT POSITION  
43.44235353 N  
122° 93154568 W

AREA BOUNDARY  
BURNED  
9/2020

Comp. Decline. 14 1/4° E  
Agency DCSD  
Party Chief S. F. Aulsebrook  
Note keeper  
Witnesses J. Lorusney

CS 67161-44  
pg 2/3

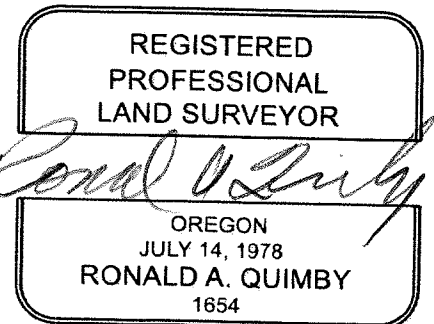

EXPIRES: 12/31/2026

PRIMARY CORNER DESCRIPTION 1/4 Cor. Secs. 33 & 34

Alias _____	Description _____
Alias _____	Description <u>TRIMBLE GEO XT POSITION</u>
Alias _____	Description _____
Alias _____	Description <u>43.44235353°N</u>
Alias _____	Description <u>122.93154568°W</u>

8" dia., chinquapin double blazed & scribed "¼ S34 CS BT" bears N.72°E., 27.0 ft.  
 6" dia., D.Fir double blazed & scribed "¼ S34 CS BT" bears S.75¼°E., 20.0 ft.  
 19" dia., D.Fir double blazed & scribed "¼ S33 CS BT" bears S.48¼°W., 18.4 ft.

Note - Corner lies on moderate south facing slope. Mature timber to west.  
 Compass decl. 16¼°E.

DECLINATION 14¼°E RENEWED 12/2/25

Ron Quimby - Crew: N. Fromdahl & R. Olsen - 5/2015 - C.S. File 65/89-3

Found - GLO brass cap (properly mkd) 2 1/2" B.C. / 3/4" I.D.I.P. PROT. 6"  
 9" Chincapin N.72°E., 27.0 ft. vis. scribe. BLAZE BURNED OUT  
BURNED DEAD 9" 9" D.Fir S.75°E., 20.0 ft. vis. scribe. 3 AND NOTCH REMAIN  
ROTTED BURNED 8 1/2" x 1 1/2" STUMP 19" D.Fir S.48°W., 18.4 ft. vis. scribe. FHDB (ADD MAG NAIL L.S.C.)  
BURNED DEAD 20" 19" D.Fir N.70°W., 7.3 ft. healed face ✓  
BURNED DEAD 33" 31" D.Fir N.70°W., 7.3 ft. healed face ✓  
26" x 1 FT. 28" x 2' tall D.Fir stump S.89°E., 36.3 ft. mostly rotten. MOSTLY GONE  
 Note - Corner is on moderate West slope approx. 300' SW of road. ADD 3 1/2" MAG NAIL R.S.C. TO CHINQUAPIN AND  
 Compass decl. 15½°E. 33" NW FIR B.T.

NEW REF.  
BURNED DEAD 40" D.FIR, 3 1/2" MAG NAIL R.S.C.; BEARS N30°W, 159 FT. DIST.

CS 67161-44 pg 3/3