

GOVERNMENT CORNER RESTORATION FORM

FILED

TOWNSHIP 25S RANGE 3W SEC. 11

PLSS # 540500

Date: 12/11/25 By: ve
This survey consists of:

DOUGLAS COUNTY OREGON

DATE 12-10-25

Map: _____

Narrative: _____

Corner Rpt: CS 67/61-51

Corner Designation

$\frac{1}{4} \frac{S11}{S14}$

DOUGLAS COUNTY
SURVEYOR

Monument(s) Found: (Condition and Source)

2 1/2" GLO BRASS CAP
LOANS N 0²± BUT SOLID
IN ROCKY SOIL APPEARS UNDISTURBED

___ Condition report

___ Not Found

Renewed

___ Unrecorded

___ Surveyed In

Previous Renewals

GLO Resurvey 1940 Vol 27 p 11560
DCSO 1966 CS 54/27-55

MONUMENT DETAIL

$\frac{1}{4} \frac{S11}{S14}$
1943

Accessories Found

Burnt out CEDAR stub S 88°W 38.3 FT TO ROOT
Center

15" X 7 FT BROKE D. FIR SWAG N 73°E 5.5 FT
NO BLAZE VISIABLE ADD 3 1/2" MAG NAIL
RIGHT SIDE CENTER

14" X 8 FT SAWN BURNED D. FIR SWAG
S 45°W 12.9 FT FULLY HEALED SINGLE BLAZE
ADD 3 1/2" MAG NAIL RIGHT SIDE CENTER

New Accessories

14" X 1 1/2 FT D. FIR STUMP S56°E 13.0 FT
ADD 3 1/2" MAG NAIL TOP CENTER

12" X 1 1/2 FT D. FIR STUMP N65°W 22.5 FT
ADD 3 1/2" MAG NAIL TOP CENTER

Sketch of Monument, Accessories, and General Area

Location & Comments

MON ON M/L FLAT GROUND
IN VERY LARGE CLEARCUT
TRIMBLE GEOXT LOCATION


AREA BURNED
9/2020

43° 40' 52.5682" N
123° 0' 19.66859" W

Comp. Decline. 14 1/2" E
Agency DCSO
Party Chief S. F. HAUSE
Note keeper
Witnesses J. LORSONG

CS 67161-51

pg 2/3

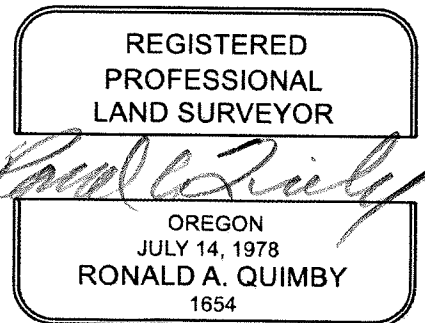

EXPIRES: 12/31/2026

TOWNSHIP 25 RANGE 03 POINT IDENTIFIER # 540500

PRIMARY CORNER DESCRIPTION 1/4 Cor. for Secs. 11 and 14

Alias _____	Description _____
Alias _____	Description <u>TRIMBLE GEO XT POSITION</u>
Alias _____	Description _____
Alias _____	Description <u>43.40525682°N</u>
	<u>123.01966859°W</u>

MINI GIS
43.40531
123.01962

Original, Laban H. Wheeler, Under Contract #467 dated April 7, 1883 (DCSO Records, Volume 9 Page 3688)

Set Cedar post 3" sq., 3 ft. long, 24" in the ground for 1/4 sec. cor. mkd. S on W. face, from which

- A Fir 30" dia., bears N.10°E., 5 lks. dist., mkd. 1/4 S BT.
- A Hemlock 18" dia., bears N.19°W., 17 lks. dist., mkd. 1/4 S BT.

GLO Dependent Resurvey by Norman D. Price, Under Special Instructions dated April, 5, 1940. (DCSO records, Volume 27 Page 11560)

Proportional measurement. Set an iron post, 3 ft. long, 1" dia., 28" in the ground, for 1/4 sec. cor. with brass cap mkd. STAMPED 1/4 $\frac{S11}{S14}$ " LEANS NORTH ~ 0° BUT VERY SOLID IN ROCKY SOIL

2 1/2" GLO CAP 1943 from which APPEARS UNDISTURBED

- A Fir 40" dia., bears N.25 1/2°E., 70 lks. dist., mkd. 1/4 S11 BT.
- An Incense Cedar 28" dia., bears S.89°W., 58 lks. dist., mkd. 1/4 S14 BT.

DECLINATION 14'14" E

RENEWED 12/10/25

Doug. County Surveyors Office - Vernon Tracy; Joe Brady; Jack Heritage - July/Aug. 1966 - C.S. File 54/27-55

Found SEE ABOVE GLO brass cap mkd. 1943, and steel fence post FNC. POST IS ~ 0 3 FT NORTH alongside. TO ROOT CNTR

BURNED OUT STUBS 28" ~~now 32"~~ Cedar stump S.89°W., 38.3 ft., shows scribe.

15" x 7 FT BURNED BROKEN OFF SNAG NE BT, now burned & turned out stump, no scribe fd.

14" x 8 FT. BURNED SAWN SNAG New BTs 6" D. Fir N.73°E., 5.5 ft. mkd. 1/4 S11 CS BT. BLAZE NOT VISIBLE

7" D. Fir S.45°W., 12.9 ft. mkd. 1/4 S14 CS BT. FHSB

To expose brass cap, we cut a 24" piece out of a log and straighten brass cap. Corner lies in old logging, now grown up to very thick D. Fir reproduction. ADD 3 1/2" MAG NAIL R.S.C. TO FOUND B.T.S

NEW REFERENCES:

- A 14" x 1 1/2 FT. D. FIR STUMP WITH A 3 1/2" MAG NAIL SET TOP CENTER; BEARS S56°E, 13° FT. DIST.
- A 12" x 1 1/2 FT. D. FIR STUMP WITH A 3 1/2" MAG NAIL SET TOP CENTER; BEARS N65°W, 22 1/2 FT. DIST.

MONUMENT IS ON M/L FLAT GROUND IN VERY LARGE BURNED CLEARCUT 1