

TOWNSHIP 24S RANGE 2W SEC. 34

PLSS # 420200

Date: 1/17/26 By: KE  
This survey consists of:

DOUGLAS COUNTY OREGON

DATE 12-30-25

Map: \_\_\_\_\_  
Narrative: \_\_\_\_\_  
Corner Rpt: CS 07161-54

Corner Designation \*

N. 1/4 1/4 S 34

DOUGLAS COUNTY SURVEYOR

Monument(s) Found: (Condition and Source)

2 1/2" Alum. Cap on  
5/8" Iron Rod Flush  
with Ground

- Condition report
- Not Found
- Renewed
- Unrecorded
- Surveyed In

Previous Renewals

Set by EDWARDS IN 2008  
M 156-7

MONUMENT DETAIL

T 24 S 2 W  
\* N 1/4 1/4  
S 34  
L 5 2339  
2608

\* Corrected 5/26/2026

Accessories Found

N 1/4 Secs 27  
34

None

---



---



New Accessories

Burnt 50" X 4 FT Cedar Stump N59°E  
 9.3 FT 4" MAG NAIL RIGHT SIDE CENTER

22" X 6 FT BURNED FIR Stump N120°E  
 19.7 FT 4" MAG NAIL RIGHT SIDE CENTER

---



---



Sketch of Monument, Accessories, and General Area

Location & Comments

Cor on steep west slope

Cor is approx 200  
 FT S.W. of Logging  
 Landing

OCRS Coordinates Cottage  
 Grove. Canyonville Zone


Area Burnt  
 9/2020

N 224750.634


E 272033.762

Comp. Decline. 14 1/4°E  
 Agency DLSO  
 Party Chief J. Korsun  
 Note keeper \_\_\_\_\_  
 Witnesses \_\_\_\_\_

CS 67141-56 pg 24

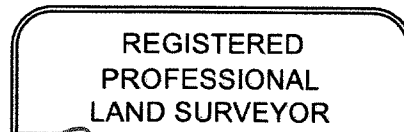

*Ronald A. Quimby*

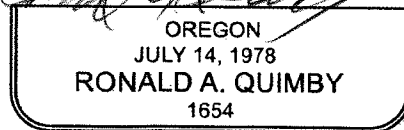

EXPIRES: 12/31/2026

NARRATIVE

THE PURPOSE OF THIS SURVEY IS TO MARK THE BOUNDARIES OF THE NE 1/4 OF SECTION 34. TIES WERE MADE TO THE CONTROLLING CORNERS AND THE SUBDIVISION OF THE SECTION COMPUTED AS SHOWN. THE SUBJECT LINES WERE MARKED BY BLAZING TREES ON EACH SIDE OF LINE, BY SETTING 6 FOOT STEEL POSTS ALONG LINE AT INTERVALS OF 200' OR LESS AND BY HANGING LIBERAL AMOUNTS OF RED FLAGGING ALONG THE TRUE LINE. MONUMENTS AND BEARING TREES MARKED ON THIS SURVEY WERE DONE SO ACCORDING TO THE 1973 MANUAL SAID BEARING TREES WERE MEASURED TO CENTER OF TREE AT ROOT CROWN AND ARE SITUATED AS FOLLOWS:

AT THE WEST 1/16 CORNER TO SECTIONS 27 AND 34:

- A 2" DIAM. FIR BEARS N.15°E., 19.35 FEET
- A 2" DIAM. FIR BEARS S.4°W., 10.45 FEET

AT THE NW 1/16 CORNER OF SECTION 34:

- ~~A 20" DIAM. FIR BEARS S.69°E., 14.70 FEET~~
- ~~A 6" DIAM. CEDAR BEARS S.33°W., 8.73 FEET~~

GONE

AT THE CENTER-NORTH 1/16 CORNER OF SECTION 34:

- A 9" DIAM. FIR BEARS N.37°E., 8.25 FEET
- A 10" DIAM. CEDAR BEARS N.79°W., 4.75 FEET

GONE

FIELD CREW: BRANT MILLER AND ERIC SPRINKLE.

EQUIPMENT: NIKON TOTAL STATION.

COMPUTATIONS AND DRAFTING: DAVID EDWARDS.

OCCRS N - 224750.636 , E - 272033.767

CORNER LIES APPROX. 200 FT SOUTHWEST OF LOGGING LANDING, FLUSH WITH THE GROUND ON A STEEP WEST SLOPE. ALL STUMPS RIGHT SIDE CENTER SPIKED W/ 4" MAG NAILS.

50' X 4' BURNED CEDAR STUMP, N 59° E, 9 3/4 FT  
22" X 6 FT BURNED FIR STUMP, N 20° E, 19 1/2

12-30-25

24-2-34 MAG 1/8 \*  
w/116 Secs 27/34

1/28/80

29-10-1984



\*

Corrected 5/26/2026  
SIF&X

