

TOWNSHIP 245 RANGE 2W SEC. 34

PLSS # 440160

Date: 1/12/20 By: KE

This survey consists of:

Map: _____

Narrative: _____

Corner Rpt: CS 07/01-57

DOUGLAS COUNTY OREGON

DATE 1-05-26

DOUGLAS COUNTY
SURVEYOR

Corner Designation

C N 1/16 S 34

Monument(s) Found: (Condition and Source)

2 1/2" Alum. Cap on 5/8"
Iron Rod proj. 3"

___ Condition report

___ Not Found

___ Renewed


___ Unrecorded

___ Surveyed In

Previous Renewals

EDWARDS set per M 156-7
2008

MONUMENT DETAIL

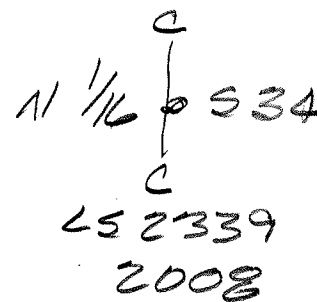

Accessories Found

Burnt. dead 14" Cedar N 65W 4.75ft (Rec
N 79W to BT Tag) Partly Healed single
BLAZE Add 3 1/2" mag Nail Right Side
Center

BURNED fallen out of position 12" Hemlock
Root Hole obliterated PARTLY Healed
Single BLAZE

Monument Set (Procedure and Description)

MONUMENT DETAIL

New Accessories

5/8" x 20" Iron Rod with DCSD plastic
CAP proj. 3" North 11.0 FT

Sketch of Monument, Accessories, and General Area

Location & Comments

MON on moderate south slope
6 FT ± N45°W from seasonal
stream large clear cut to
north all burned

AREA BURNED
9/2020

OERS Cottage Grove -
Canyonville zone

Comp. Decline. 14 1/4° E
Agency DLSD
Party Chief S. F. HAUSE
Note keeper
Witnesses J. LORSHING

43. 44 568055 N
122. 92222 413 W

REGISTERED
PROFESSIONAL
LAND SURVEYOR

Ronald A. Quimby

OREGON
JULY 14, 1978
RONALD A. QUIMBY
1654

EXPIRES: 12/31/2026

NARRATIVE

THE PURPOSE OF THIS SURVEY IS TO MARK THE BOUNDARIES OF THE NE 1/4 OF THE NW 1/4 OF SECTION 34. TIES WERE MADE TO THE CONTROLLING CORNERS AND THE SUBDIVISION OF THE SECTION COMPUTED AS SHOWN. THE SUBJECT LINES WERE MARKED BY BLAZING TREES ON EACH SIDE OF LINE, BY SETTING 6 FOOT STEEL POSTS ALONG LINE AT INTERVALS OF 200' OR LESS AND BY HANGING LIBERAL AMOUNTS OF RED FLAGGING ALONG THE TRUE LINE. MONUMENTS AND BEARING TREES MARKED ON THIS SURVEY WERE DONE SO ACCORDING TO THE 1973 MANUAL SAID BEARING TREES WERE MEASURED TO CENTER OF TREE AT ROOT CROWN AND ARE SITUATED AS FOLLOWS:

AT THE WEST 1/16 CORNER TO SECTIONS 27 AND 34:

- A 21" DIAM. FIR BEARS N.15°E., 19.35 FEET
- A 21" DIAM. FIR BEARS S.41°W., 10.45 FEET

T24S, R02W, 440160

AT THE NW 1/16 CORNER OF SECTION 34:

- A 20" DIAM. FIR BEARS S.69°E., 14.70 FEET
- A 6" DIAM. CEDAR BEARS S.23°W., 8.73 FEET

DECLINATION 14 1/4° E

RENEWED 01/05/26

AT THE CENTER-NORTH 1/16 CORNER OF SECTION 34:

BURNED FALLEN OUT OF POSITION 12" DIA, A 9" DIAM. ~~FIR~~ BEARS N.37°E., 8.25 FEET PH 5 B BURNED FACE
 BURNED DEAD 14" A 10" DIAM. CEDAR BEARS N.79°W 4.75 FEET AND 3 1/2" PH 5 B BURNED FACE

HEMLOCK HOOTHOLE OBLITERATED

FIELD CREW: BRANT MILLER AND ERIC SPRINKLE.

EQUIPMENT: NIKON TOTAL STATION.

COMPUTATIONS AND DRAFTING: DAVID EDWARDS.

NEW REFERENCE:

A 5/8" x 30" IRON/DCSO PLASTIC CAP, SET PROT. 3" ABOVE GROUND; BEARS NORTH, 11° FT. DISTANT

O.C.R.S. CANYONVILLE COTTAGE GROVE POSITION

43.44568055° N

122.92222413° W

2 1/2" ALUM CAP ON 5/8" I.R.
PROT 3" ABV. GRND
CAP IS STAMPED " C

N 1/16; 534

LS 2339
MAG. NAIL P.S.C.
(AT RECIDIST) 2008

BEARING TO B.T. TAG
C.R.C BEARING N 65° W

MON. ON MODERATE SOUTH SLOPE
~ 6 FT. N 45° W FROM SEASONAL STREAM
LARGE CLEAR CUT TO NORTH, ALL BURNED.