

GOVERNMENT CORNER RESTORATION FORM

FILED

TOWNSHIP 245 RANGE 241 SEC. 26 PLSS #540206

Date: 1/28/26 By: KE  
This survey consists of:

DOUGLAS COUNTY OREGON

DATE 1-6-26

Map: \_\_\_\_\_

Narrative: \_\_\_\_\_

Corner Rpt: CS 67161-59

Corner Designation

$\frac{1}{4}$   $\frac{26}{35}$

DOUGLAS COUNTY  
SURVEYOR

Monument(s) Found: (Condition and Source)

\_\_\_ Condition report

1951 BLM BRASS CAP  
Proj 6"

\_\_\_ Not Found

Renewed

\_\_\_ Unrecorded

\_\_\_ Surveyed In

Previous Renewals

Blm Resurvey 1951-1963  
No 32 pg 13294  
DCSO 1969 CS 54127-242  
Smalley 2009 CS 65166-43  
Quimby 2020 CS 65106-5

MONUMENT DETAIL

$\frac{1}{4}$   $\frac{524}{535}$   
1951

Accessories Found

Burnt-Rotted 4" FIR S14 1/2° E 64.7 FT 20' TALL  
SPAG Fully healed Single BLAZE  
10" Hemlock N152° E 6.4 FT PARTLY Healed  
Single BLAZE scribe visible  
SAWN 10" X 3 FT D. FIR STUMP N110° E 15.1 FT  
(REC N6° E 15.0 FT) NAIL TOP CENTER  
11" D. FIR N31° W 9.7 FT (REC 9.6)  
Fully Healed Single BLAZE  
9" Hemlock Fallen out of position No  
Good Root Hole PARTLY Healed Single  
BLAZE Scribes visible  
Metal Posts S45° E 1.6 FT AND  
N70° W 1.0 FT  
All trees are side spiked

Monument Set (Procedure and Description)

MONUMENT DETAIL

New Accessories

5" Hemlock High Low BLAZE MARKED  
X BT S40°W 3.4 FT 3 1/2" MAG NAIL  
RIGHT Side Center

Sketch of Monument, Accessories, and General Area

Location & Comments

MON ON moderate North  
Slope old Growth Forest  
South LARGE Clearcut To  
North

MON APPROX 90  
FT SOUTH OF  
GRAVE ROAD

AREA BURNED  
9-2020

Trimble Geo XT Position

Comp. Decline. 14 1/4° E

Agency DCSD

Party Chief S. FRAUSE

Note keeper


Witnesses J. LORSON

43.44969891 N


122.90209980 W

CS67/61-59

pg 2/4

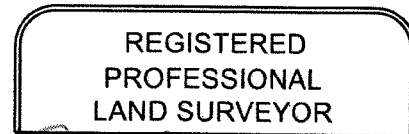

Ronald A. Quimby

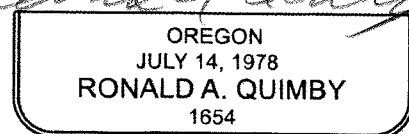

EXPIRES: 12/31/2026

TOWNSHIP 24 RANGE 02 POINT IDENTIFIER # 540200

PRIMARY CORNER DESCRIPTION 1/4 Cor. Secs. 26 & 35

Alias \_\_\_\_\_ Description \_\_\_\_\_  
Alias \_\_\_\_\_ Description \_\_\_\_\_  
Alias \_\_\_\_\_ Description \_\_\_\_\_  
Alias \_\_\_\_\_ Description \_\_\_\_\_

GLO Survey by Henry L. Chandler, U.S. Deputy Surveyor, under Contract #619 dated June 5, 1893 - (DCSO records Vol. 7 Page(s) 2903)

-----  
Set post, 3 ft. long, & 3" sq., 24" in the ground for the 1/4 sec. cor. marked 1/4 S on N face, from which:

A fir, 12" dia., bears N.52°E., 22 lks., mkd: 1/4 S BT.

A cedar, 8" dia., bears S.70°W., 36 lks., mkd: 1/4 S BT.

BLM dependent resurvey Levi E Tallett, Cadastral Engineer (1951) and C. Albert White, Cadastral Surveyor (1963), under Group # 294, surveyed May 1951 - Aug 1963 - (DCSO records Vol. 32 Page(s) 13294)

-----  
The 1/4 sec. cor. of secs. 26 & 35, determined from the remains of the orig. BTs.

A fallen fir, 18" dia., bears N.52°E., 22 lks., blazed healed, edge of face under 56 yrs. of overgrowth, down for approx. a year.

A fallen cedar, 18" dia., bears S.70°W., 36 lks., blaze healed.

At corner point

Set an iron post, 36" long, 1" dia., 28" in the ground, with brass cap marked:

1/4  $\frac{S\ 26}{S\ 35}$   
1951

from which

A fir, 26" dia., bears N.42°45'E., 102 lks., mkd: 1/4 S26 BT

A fir, 40" dia., bears S.14 1/2°E., 98 lks., mkd: 1/4 S35 BT.

Douglas Co. Surveyors Office - Vernon "Ray" Tracy - Jack Heritage - V. Perron - Aug. 20 1969 - C.S. File 54/27-242

-----  
Found - 1951 Cad. brass cap in place, properly mkd.  
26" now 27" fir, low cut stump, N.42 3/4°E., 67.3 ft., find scribe.

40" now 41" fir, alive, S.14 1/2°E., 64.7 ft., pitched blaze.

New BT - 9" Hemlock N.83°W., 24.1 ft., mkd: "1/4 S26 CS BT"

Note - This corner lies 5 ft. south of cat fir trail for recent logging in Sec. 26.

*RENEWED 1/6/26*

Mark Smalley, Roseburg Forest Products - Party Chief: William Olson - Witness Niel Danko - June 2009 - C.S. File 65/66-43

-----  
Found - 1951 Cad brass cap, properly marked ✓ *PROT. 6"*  
*GONE DUE TO CAT WORK* ~~27" fir, low cut stump, N.42°E. (Rec. N.42°45'E), 67.3' 1951~~ continued next page

*pg 3/4 CS 67/66-59*

TOWNSHIP 24 RANGE 02 POINT IDENTIFIER # 540200

PRIMARY CORNER DESCRIPTION 1/4 Cor. Secs. 26 & 35

Alias \_\_\_\_\_ Description TRIMBLE GEO XT POSITION

Alias \_\_\_\_\_ Description \_\_\_\_\_

Alias \_\_\_\_\_ Description 43.44904891°N

Alias \_\_\_\_\_ Description 122.90209980°W

A METAL LATH FOUND S45°E, 16 FT. DIST AND N70°W, 10 FT. DIST.

BURNED ROTTED 44 1/2" fir S. 14 1/2° E. ✓ 64.7 ✓ <sup>20'</sup> tall snag, 1951 ALL FOUND B.T.S  
~~NO EVID. 9" Hemlock, N. 83° W. 24.1', gone 1969~~ HAVE MAG NAIL R.S.G.  
 New LIVE 10" 8" Hemlock ✓ N. 52° E. ✓ 6.4 ✓ measured to nail in side EXCEPT STUMP  
 center of stump RC scribed "S1/4BT" PHSB SCRIB'G VISIBLE

SAWN 10" X 3 FOOT - 8" STUMP D. Fir ✓ N. 8° E., 15 ~~5~~ 0' measured to nail in side TOP CENTER  
 center of stump RC scribed "S1/4BT" FHSB MAG NAIL

LIVE 11" 7" D. Fir ✓ N. 31° W ✓ 9 ~~2~~ 8' measured to nail in side  
 center of stump RC scribed "S1/4BT" FHSB

FALLEN OUT OF POSITION 9 7/8" Hemlock ✓ S. 52° E., 31.1' measured to nail in side NO GOOD  
 center of stump RC scribed "S1/4BT" PHSB SCRIB'G VIS. ROOTHOLE

Fd Ok by R Quimby 10/2020 - C.S. File 65/106-51

NEW REF:

A 5" HEMLOCK WITH A HIGH LOW "X" "BT" BLAZE AND A 3 1/2" MAG NAIL R.S.G. ; BEARS S40°W, 3 ± FT. DISTANT.

BC MONUMENT ON MODERATE NORTH SLOPE AND APPROX 90 FT. SOUTH OF GRAVEL ROAD, OLD GROWTH FOREST SOUTH, LARGE CLEARCUT TO NORTH.