

TOWNSHIP 245 RANGE 2W SEC. 28 PLSS # 340200

Date: 1/28/26 By: KC
This survey consists of:

DOUGLAS COUNTY OREGON

DATE 1-21-26

Map: _____

Narrative: _____

Corner Rpt: CS 07/62-02

Corner Designation

1/4 COR 28
33

DOUGLAS COUNTY
SURVEYOR

Monument(s) Found: (Condition and Source)

2 1/2" BLM BRASS CAP
ON IRON PIPE IN ROUGH
STONE MOUND LEADS SSE
0.9 FT

___ Condition report

___ Not Found

Renewed

___ Unrecorded

___ Surveyed In

Previous Renewals

BLM RESURVEY 1951 TO 1963
VOL 32 PG 13300
BAKER 2018 CS 65/103-2

MONUMENT DETAIL

1/4 528
533
1951

Accessories Found

SAWN - ROTTED - BURNED 34" X 4 FT FIR STUMP
N70°W 37.4 FT (REC N64°W 58 LKS) FULLY
HEALED SINGLE BLAZE

SAWN BURNED 10" X 4 FT FIR STUMP N120°E 15.6 FT
(REC N15°E 16.1 FT) PARTLY HEALED SINGLE BLAZE
ALL SCRIBING VISIBLE

BURNED - BROKEN 11" X 12 FT SWEEPING FIR SNAG
S53°E 12.2 FT (REC 11.8 FT) PARTLY HEALED SINGLE
BLAZE ALL SCRIBES VISIBLE

BURNED BROKEN OF 8" X 3 FT FIR STUMP S13°W 9.9 FT
(REC 9.3 FT) PARTLY HEALED SINGLE BLAZE ALL SCRIBES
VISIBLE

SAWN BURNED 6" X 1 FT FIR STUMP N77°W 6.7 FT
(REC N74°W 7.2 FT) PARTLY HEALED LOW BLAZE
SCRIBE BT VISIBLE

ALL BEARING TREES ARE FOUND WITH 6"
STEEL SIDE SPIKES

over

~~New~~ Accessories

ORIGINAL DIST were TO TOP OF LEARNING
MONUMENT. WE PLUMBED MONUMENT AND
ALL DISTANCE TO PLUMB POSITION CONST.
LARGE MOUND OF STONE MONUMENT NOW
PROJ. 4" FROM TO OF MOUND RESET METAL
POST 1.5 FT EAST

Sketch of Monument, Accessories, and General Area

Location & Comments


Trimble GEO XT POSITION
43° 44' 929861 N
122° 9' 4090599 W

AREA BURST
9/2020

Comp. Decline. 14 1/2° E
Agency DCSO
Party Chief S. FLAUSC
Note keeper
Witnesses J. KORSUNG

CS 07102-02

pg 2/3

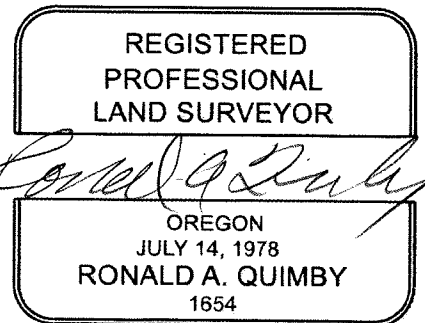

EXPIRES: 12/31/2026

PRIMARY CORNER DESCRIPTION 1/4 Cor. Secs 28 & 33

Alias _____	Description _____
Alias _____	Description <u>TRIMBLE GEO XT POSITION</u>
Alias _____	Description _____
Alias _____	Description <u>43.44929861° N</u>
	<u>122.94090599° W</u>

GLO Survey by Henry L. Chandler, U.S. Deputy Surveyor, under Contract #619 dated June 5, 1893 - (DCSO records Vol. 7 Page(s) 2913-4)

Set a basalt stone 16x9x6" 11" in the ground for 1/4 sec. cor. marked 1/4 on W face, from which
A hemlock, 6" dia., bears S.74°W., 28 lks., mkd: 1/4 S BT.
A fir, 36" dia., bears N.70°W., 58 lks., mkd: 1/4 S BT.

BLM dependent resurvey Levi E Tallett, Cadastral Engineer (1951) and C. Albert White, Cadastral Surveyor (1963), under Group # 294, surveyed May 1951 - Aug 1963 - (DCSO records Vol. 32 Page(s) 13300)

The 1/4 sec. cor. of secs. 28 & 33, monumented with a basalt stone, 15x8x6", firmly set, marked 1/4 on N face, from which the orig. BTs:

SAWN ROTTED BURNED 34" x 4 FT TALL STUMP

A fir, ~~50"~~ ^{70° 37'} dia., bears N. ~~64°~~ W., ~~58~~ lks., blaze healed (Rec. bearing N.70°W.) **FHSB**
A hemlock, 12" dia., bears S.68°45'W., 20 lks., blaze partially healed, partial scribe marks visible. (Rec. S.74°W., 28 lks.)

At the corner point
Set an iron post, 36" long, 1" dia., 12" in the ground to ~~the~~ d rock, and in a mound of stone, 4 ft., base to top, with brass cap mkd:
1/4 S 28
S 33
1951

ALL B.T.S BELOW ARE FOUND WITH A 6" STEEL SIDESPIKE

from which
A fir, 60" dia., bears S.0 1/4°W., 63 lks., mkd: 1/4 S33 BT.
Bury the orig. corner stone alongside the iron post.
DECLINATION 14 1/4° E

ALL 2018 RECORD MEASUREMENTS WERE TO TOP OF LEANING MON.

Dan Baker - For: Weyerhaeuser Co. 12/2018 - C.S. 65/103-2
 Found - 2 1/2" ^{20°} GLO brass cap "1951" on 1" iron post (up 2 ft) *LEANING SSE 9 FT*
 "1" ¹⁵⁶ Fir N.15° E. 16.1' to spike side/center-scribed *NEW DISTANCES ARE TO PLUMBED MON.*
 "1/4 S28 BT" *PHSB ALL SCRIBING VISIBLE*
 Sweeping Fir S.53° E, 11.8' ¹²³ to spike side/center-scribed "1/4 S33 BT" *PHSB ALL SCRIBING VISIBLE*
 Fir S.13° W. ⁹² 13' to spike side/center-scribed "1/4 S33 BT" *PHSB ALL SCRIBING VISIBLE*
 Fir N.74° W. ⁶⁵ 2' to spike side/center-scribed "1/4 S28 BT" *PHSB ALL SCRIBING VISIBLE*
 5 FT metal post alongside corner *ON NORTH EDGE AT PLUMB POSITION*

SAWN BURNED 10x4

BURNED BROKEN TOP 11x12 FT. SNAG

BURNED BROKEN OFF 8x3' STUMP

SAWN BURNED 6x1' STUMP

77°

*FOUND MONUMENT IS PLUMBED; ADD LARGE MOUND OF STONE, MON. NOW PROT. 4 INCHES ABOVE TOP OF MOUND.
FOUND METAL LATH NOW SET 1 1/2 FT. EAST. CS 07/02-02 pg 3/3*