

GOVERNMENT CORNER RESTORATION FORM

FILED

TOWNSHIP 25S RANGE 2W SEC. 17 PLSS # 200440

Date: 2/4/20 By: ke
This survey consists of:

DOUGLAS COUNTY OREGON

DATE 2-3-20

Map: _____

Narrative: _____

Corner Rpt: CS 07/12/20

Corner Designation

1/4 COR S13/S17

DOUGLAS COUNTY
SURVEYOR

Monument(s) Found: (Condition and Source)

DCSO BRASS CAP ON
IRON PIPE WITH STONE
ALONG SIDE IN 2 FT BY 1 FT
Previous Renewals STONE MOUND

___ Condition report

___ Not Found

Renewed

___ Unrecorded

___ Surveyed In

BAUGHMAN 1976 M 56-35
DCSO 1989 CS 62/43-1
Quimby - 2014 M 167-34 A&B

MONUMENT DETAIL

Accessories Found

BURNED - DEAD 20" double Trunked Cedar
EAST TRUNK North 23.8 (REC 24.2) GOOD
SCAR ADD 3 1/2" MAG NAIL RIGHT SIDE
Center

12" X 1 FT SAWW - BURNED STUMP N71°W
23.5 FT (REC N72°W 23.6 FT) ADD 3 1/2"
MAG NAIL TOP Center

59" X 40 FT D. FIR SWAG S75°E 4.7 FT (REC
4.5 FT ADD 3 1/2" MAG NAIL RIGHT SIDE
Center

Monument Set (Procedure and Description)

MONUMENT DETAIL

New Accessories

16" X 1 FT SAWN BURNT FIR STUMP
 S 80°W 39.0 FT 3 1/2" MAG NAIL
 Top Center

Sketch of Monument, Accessories, and General Area

Location & Comments

MON 13 IN A North/South
 cut line on south sloped
 bench


DCRS coordinates
 Cottage Grove - Canyonville
 zone

N 205025.174
 E 259903.074

Comp. Decline. 14 1/4° E
 Agency DCSO
 Party Chief S. F. Hulse
 Note keeper _____
 Witnesses J. Loring

CS 67162-06 pg 2/4

REGISTERED
 PROFESSIONAL
 LAND SURVEYOR

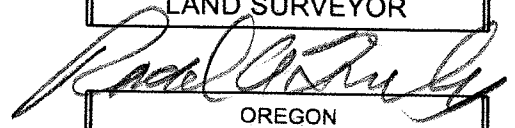

OREGON
 JULY 14, 1978
 RONALD A. QUIMBY
 1654

EXPIRES: 12/31/2026

TOWNSHIP 25 RANGE 02 POINT IDENTIFIER # 200440

PRIMARY CORNER DESCRIPTION 1/4 Cor. Secs. 17 & 18

Alias _____	Description _____
Alias _____	Description _____
Alias _____	Description _____
Alias _____	Description _____

MINI GIS
43.39525
122.97278

GLO Survey by Hezekiah H. Johnson, under Contract #721, dated May 1, 1900 (DCSO records Vol. 9 Page(s) 3649)

Set basalt stone 18x8x6", 12" in the ground for 1/4 sec. cor. marked 1/4 on W face, from which

A fir, 40" dia., bears S.75°E., 3 lks., mkd: 1/4 S17 BT.

A cedar, 20" dia., bears N.65°W., 53 lks., mkd: 1/4 S18 BT.

Fd. ok by G. Baughman - 1/1976 M56-35

Douglas Co. Surveyors Office - Randall W. Smith - Stephen J. Flause - 4/6/1989 - C.S. File 62/63-1

Found - Original stone, firmly set measuring 6"x8" on top & protruding 7" above ground. Orig. stone is clearly marked "1/4" on west side. (When removed stone measured 18" long)

40" now 49" dia. D.Fir with a fully healed double blaze & axed marks on bark "L X" bears S.75°E., 4.5 ft. (Rec. S.75°E., 2.0 ft. possible face measurement) Orig. BT.

20" now 32" dia. 2 ft. high cedar stump, with a lower healed blaze; stump has a rotted out center with an axe mark at bottom of blaze. No scribing found. Bears N.71 1/2°W., 35.0 ft. (Orig. rec. N.65°W., 35.0 ft.) Orig. BT.

Set - Orig. stone is referenced and a 8 1/4" long boat spike with a 1 1/4" dia. head stamped "DCSO 1/4 1989" is set at reference position 15" below ground.

A 2 3/8" dia. brass cap on a 1 3/8" O.D. by 32" long I.P. is set over boat spike at referenced position and protrudes 13" above ground. Original stone is set along east edge of BC/IP with side mkd. "1/4" facing west, stone protrudes 4" above ground. BC/IP & orig. stone are surrounded by a 2 ft. dia. mound of stone.

New BTs- 4" D.Fir double blazed & scribed "X BT" bears S.44°W., 41.0 ft.

3" D.Fir double blazed & scribed "X BT" bears N.72 1/2°W, 23.6 ft.

A double trunked cedar double blazed & scribed on 11" dia. East trunk "1/4 S17 CS BT" bears North 24.2 ft.

Corner lies in a north-south cut line near the west edge of a small bench. Trees to the east are targeted for harvest in near future.

continued next page

TOWNSHIP 25 RANGE 02 POINT IDENTIFIER # 200440

PRIMARY CORNER DESCRIPTION 1/4 Cor. Secs. 17 & 18

Alias _____	Description _____
Alias _____	Description _____
Alias _____	Description _____
Alias _____	Description _____

DECLINATION $14^{\circ}14' E$

RENEWED 2/3/2026

Ron Quimby - For: Roseburg Resources - Feb 2014 - M167-34 A&B

Found - DCSO brass cap on iron pipe with stone alongside (properly) mkd. ~~BURNED~~

BURNED DEAD 20"

16" double trunked cedar. East trunk bears north ✓
23.8 24.2 ft visible scar ✓

11" D. Fir bears N. 72° W., 23.6 ft visible scar ✓

BURNED 59" x 40 FT SAAG

12" D. Fir bears S. 44° W., 41.0 ft visible scar. — GONE

62" D. Fir bears S. 75° E. 44.5 ft healed scar

32" Cedar stump (2 ft tall) bears N. 71° W. 35.0 ft. ^{OK}

BURNED OUT ROOT HOLE

OCRS COTTAGE GROVE/CAMPONVILLE:

N - 205025.174, E - 259903.074

ALF →

12" x 1 FT ^{BURNED} SAAG FIR STUMP, N 71° W, 23^E
TOP / CENTER SPIKED 3 1/2" MAG NAIL

NEW - 16" x 1 FT ^{BURNED} SAAG FIR STUMP, S 80° W, 39⁰
TOP / CENTER SPIKED 3 1/2" MAG NAIL

MONUMENT LIES IN A NORTH / SOUTH CUT LINE ON A SOUTH SLOPED BENCH IN A 2 FT X 1 FT TALL MOUND OF STONE PROJECTING 5".

ALL TREES ARE TAGGED + SIDE CENTER SPIKED UNLESS SPECIFIED OTHERWISE.

DECLINATION $14^{\circ}14' 2$