

TOWNSHIP 25S RANGE 3W SEC. 24

PLSS # 700340 Date: 2/4/26 By: KE  
This survey consists of:

DOUGLAS COUNTY OREGON

DATE 1-27-26

Map: \_\_\_\_\_  
Narrative: \_\_\_\_\_  
Corner Rpt: CS 67102-07

Corner Designation

E 1/4 sec 24 only

DOUGLAS COUNTY  
SURVEYOR

Monument(s) Found: (Condition and Source)

2 1/2" GLO BRASS CAP  
ON 1" IRON PIPE  
PROJ 15"

- Condition report
- Not Found
- Renewed
- Unrecorded
- Surveyed In

Previous Renewals

GLO Resurvey 1940 Vol 27 pg 11513  
DCSO 1995 CS 64/43-2  
BLM Resurvey 2014-2015  
Vol 58 pg 23332-3

MONUMENT DETAIL

Accessories Found

Very Rotted Burned 50" X 3 FT FIR STUMP  
S79 1/2° W 27.1 FT ADD 3 1/2" MAG NAIL TOP CENTER  
Burned - Solid 27" X 5 FT D. FIR STUMP  
N15 1/2° W 32.3 FT FACE BURNED OFF ADD  
3 1/2" MAG NAIL RIGHT SIDE CENTER  
Burned - SAWN 22" X 2 FT Hemlock Stump  
S77 1/4° W 12.0 FT Healed BLAZE ADD 3 1/2"  
MAG NAIL TOP CENTER  
Burnt - SAWN 19" X 1 1/2 FT FIR STUMP N79° W  
26.1 FT Healed BLAZE ADD 3 1/2" MAG NAIL  
TOP CENTER  
Burned - SAWN 12" X 1 1/2 FT Hemlock Stump  
NORTH 23.4 FT (REC N2 1/4° W) Healed BLAZE  
PARTLY SCRIBE VISIBLE ADD 3 1/2" MAG  
NAIL TOP CENTER

RENEWAL

Monument Set (Procedure and Description)

MONUMENT DETAIL

Monument 1 FT TO West  
Reference AND Reset mon  
To plumb position projecting  
15" Add LARGE mound of  
Stove

New Accessories

Sketch of Monument, Accessories, and General Area

Location & Comments

Mon on Gentle East Slope  
Near East Edge of Square  
Mile Clear Cut


AREA BURNT  
9-2020

Trimble GEOXT LOCATION

43° 38' 16.6" N  
122° 09' 31.8" W

Comp. Decline 14 1/4° E  
Agency DCSO  
Party Chief S. F. Hulse  
Note keeper  
Witnesses J. L. Orsury

CS 07/02-07 pg 2/4

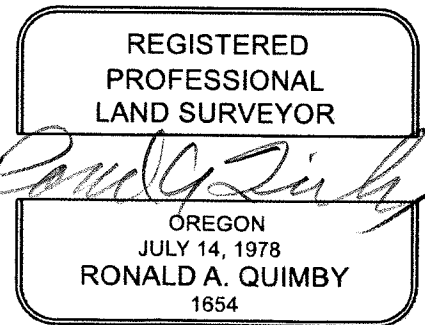

EXPIRES: 12/31/2026

PRIMARY CORNER DESCRIPTION E. ¼ Cor. Sec. 24 only

Alias _____	Description _____
Alias _____	Description _____
Alias _____	Description _____
Alias _____	Description _____

700333

433.95, N01°12'E FROM

Original, Laban H. Wheeler, Under Contract #467 dated April 7, 1883 (DCSO Records, Volume 9 Page 3587)

-----

Set Cedar post 3 ft. long, 3" sq., 24" in the ground for ¼ corner marked ¼ S on W face, from which

A Maple, 10" dia., bears N.23°E., 17 lks. dist., marked ¼ S BT.

A Cedar, 16" dia., bears S.46°E., 27 lks. dist., marked ¼ S BT.

GLO Dependent Resurvey by Norman D. Price, Under Special Instructions dated April 5, 1940 (DCSO records, Volume 27 Page 11513)

-----

Point for the original ¼ sec. cor. which now refers to sec. 24 only, determined by reference to the record measurements from both old bearing trees. At point for corner, Set an iron post 3 ft. long, 1" dia., 28" in the ground, for ¼ sec. cor. of sec. 24 only, with brass cap marked:

¼ S24 |  
1943 from which

A Red Cedar 22" dia., bears S.48½°E., 27 lks. mkd. ¼ S BT. I obliterate the marks on this old BT.

A Maple, 11" dia., bears N.16°W., 17 lks., with old blaze healed. (Old BT)

A Fir 50" dia., bears S.79½°W., 41 lks., mkd. ¼ S24 BT. (New BT)

A Fir 36" dia., bears N.15½°W., 49 lks., marked ¼ S24 BT. (New BT).

Douglas County Surveyors Office - Randall Smith & Stephen Flause - 4/3/95 -C.S. 64/63 -2

-----

Found - 2½" GLO Brass cap on a 1" OD Iron pipe, protrudes 1' above ground .

10" now 13" dia, 25' high maple snag, with a fully healed single blaze, bears N.16°W., 12' (rec. N.16°W., 11.2' dist possible face measurement) new sprouts growing from base.

16" now 24" dia, 2' high cedar stump, no blazes or scribing visible, bears S.48½°E., 17.8'.

50" now 50" dia, 2' high D.Fir stump, no blazes or scribing visible, bears S.79½°W., 27.1'.

36" now 36" dia, 6' high D.Fir stump, with a fully healed single blaze, bears N.15½°W., 32.3'.

New - 6" D.Fir, double blazed and scribed "¼ S24 CS BT", bears N.73°W., 26.3'. continued next page

MINI GIS  
43.38170°N  
122.98937°W

TOWNSHIP 25 RANGE 03 POINT IDENTIFIER # 700340

PRIMARY CORNER DESCRIPTION E. 1/4 Cor. Sec. 24 only

Alias _____	Description _____
Alias _____	Description <u>TRIMBLE GEO XT POSITION</u>
Alias _____	Description _____
Alias _____	Description <u>43.38166156°N</u>
	<u>122.98931837°W</u>

4" Hemlock, double blazed and scribed "X BT", bears N.1½°W., 23.7'.  
 12" Hemlock, double blazed and scribed "¼ S24 CS BT" on a single 5' high blaze, bears S.79°W., 11.6' (lower trunk is scared).

*FND 2 1/2 BC ON 1" x 32" I.P. TOP 15" BENT WEST 1" FT REF. PLUMB POSITION REMOVE AND STRAIGHTEN*

*DECLINATION 14 1/4° E ----- BC MON RETURNED TO REF POSITION PROT 15" AND NOW HAS A LARGE STONE MOUND SURROUND*

BLM Dependent resurvey by Richard J. Dieckmann, Cadastral Surveyor, under Group No. 2749, surveyed Aug. 2014/April 2015 - (DCSO records Vol. 58 Page(s) 23332-3)  
 The ¼ sec. cor. of sec. 24 only, T.25S., R.3W., perpetuated by the Douglas Co. Surveyor's Office in 1995, monumented with an iron post, 1" dia., firmly set, projecting 3" above the ground, with a brass cap (properly) mkd. from which the remains of bearing trees mkd. by Price in 1943-44

*VERY ROTTED BURNED STUMP* D.Fir stump, *50" x 3 FT.* 54" dia.; bears S.79½°W, 27.1 ft., with no marks visible.  
*BURNED BUT SOLID* - A decayed D.Fir stump, *27"* 38" dia., 5 ft high, bears N.15½°W, 32.3 ft., with a healed blaze. *BLZ. BURNED OFF*  
*BURNED SAWN 22" x 2 FT STUMP* and BTs mkd. by the Douglas County Surveyor's Office  
 A hemlock *20"* dia., bears S.77¼°W, 12.0 ft., with scribe marks S CS visible on a partially healed blaze at breast height. *HEALED BLAZE VISIBLE INSIDE*  
*BURNED SAWN 19" x 1/2 STUMP* A D.Fir, 15" dia., bears N.74°W, 26.1 ft., with a healed blaze. *HEALED BLZ VISIBLE INSIDE NORTH*  
*BURNED SAWN 12" x 1/2 FT STUMP* hemlock *9"* dia., bears N.24°W., 23.4 ft., with a healed double blaze. *HEALED BLZ, PART SCR BG VISIBLE INSIDE*

*ADD 3 1/2" MAG NAIL TOP CENTER TO LOW SAWN STUMPS.  
 TALL STUMP HAS 3 1/2" MAG NAIL R.S.C.  
 MON. ON GENTLE EAST SLOPE NEAR EAST EDGE OF SQUARE MILE CLEARCUT.*

CS 67102-07 pg 4/4