

TOWNSHIP 24S RANGE 2W SEC. 22 PLSS # 500340

Date: 2/11/26 By: KL  
This survey consists of:

DOUGLAS COUNTY OREGON

DATE 2-10-26

Map: \_\_\_\_\_  
Narrative: \_\_\_\_\_  
Corner Rpt: CS 67102-12

Corner Designation

1/4 COR 522/523

DOUGLAS COUNTY  
SURVEYOR

Monument(s) Found: (Condition and Source)

- Condition report
- Not Found
- Renewed
- Unrecorded
- Surveyed In

BLM BRASS CAP ON  
Iron pipe up 3"  
Previous Renewals

Hosford 1957 CS 42/306-2  
BLM Resurvey 1991 Vol 51 pgs  
19241-2

MONUMENT DETAIL

T24S R2W  
1/4  
522 / 523  
1991

Accessories Found

Rotted 28" x 40' FIR SWAG N 48° E 10.6 FT  
No BLAZE visible

22" Hemlock N 61° E 3.5 FT Fully Healed  
Single BLAZE ADD 3 1/2" MAG NAIL  
RIGHT Side Center

26" x 10' FT Shattered Hemlock Stump  
N 20 3/4° W 23.1 FT Fully Healed Single  
BLAZE

New Accessories

16" Hemlock 520°W 5.3 FT Scribed  
1/4 522 BT ON SINGLE BLAZE ADD  
3 1/2" MAG NAIL RIGHT SIDE CENTER

26" x 3 FT Hemlock stump 577°W 17.0 FT  
WITH 3 1/2" MAG NAIL TOP CENTER

Sketch of Monument, Accessories, and General Area


Location & Comments

MON. ON MODERATE STEEP ENE  
SLOPE ON WEST EDGE OF  
OLD GROWTH LARGE CLEARCUT  
TO WEST

MON IS APPROX.  
220 FT EAST OF  
LOGGING SPUR  
AREA BURN T  
9/2020

Trimble GED AT POSITION  
43° 49041713 N  
122° 91237684 W

Comp. Decline. 19 1/4° E  
Agency DCSO  
Party Chief S. Flouse  
Note keeper  
Witnesses J. Loesung

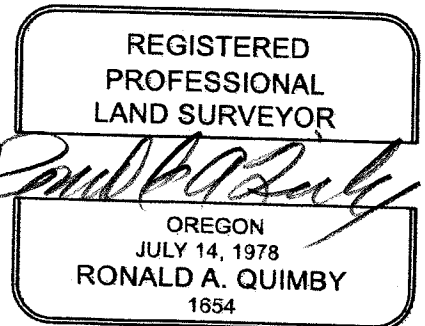

EXPIRES: 12/31/2026

TOWNSHIP 24 RANGE 02 POINT IDENTIFIER # 500340

PRIMARY CORNER DESCRIPTION 1/4 Cor. Secs. 22 & 23

Alias _____	Description _____
Alias _____	Description <u>TRIMBLE GEO XT POSITION</u>
Alias _____	Description _____
Alias _____	Description <u>43.47041713°N</u>
	<u>122.91237684°W</u>

GLO Survey by Henry L. Chandler, U.S. Deputy Surveyor, under Contract #619 dated June 5, 1893 - (DCSO records Vol. 7 Page(s) 2905)

-----

Set a basalt stone 12x12x10" 8" in the ground for 1/4 sec. cor. marked 1/4 on W face, from which

- A fir, 36" dia., bears N.48°E., 14 lks., mkd: 1/4 S BT.
- A fir, 5" dia., bears S.64°W., 19 lks., mkd: 1/4 S BT.

V.W. Hosford - Sept. 1957 - C.S. File 42/306-2

-----

Before logging, the orig. stone corner could not be found. There was evidence of an old rotted stump in the correct position of BT for Sec. 22. The BT for Sec. 23 was a dead snag with scribing visible.

After logging in Sec. 22 only the BT for Sec. 23 remains. At the true point of the corner, I drove a 1 1/2" iron pipe 36" long, 24" in the ground, from which:

- A hemlock, 10" dia., bears N.57°E., 3.2 ft., mkd: 1/4 S 23 253 BT.
- A hemlock, 12" dia., bears N.20°W., 22.5 ft., mkd: 1/4 S 22 253 BT.

DECLINATION 14 1/4° E

RENEWED 2/10/26

BLM dependent resurvey by Bryan S. Seibold, Cadastral Surveyor, under Group #1624, surveyed Aug./Oct. 1991 - (DCSO records Vol. 51 Page(s) 19241-2)

-----

The 1/4 sec. cor. of secs. 22 & 23, perpetuated & recorded by Hosford, in 1957, monumented with an iron pipe, 1 1/2" dia., firmly set, projecting 12" above ground, from which the remains of an original BT:


*VERY ROTTED 28" x 40" SNAG* A fir snag, 42" dia., bears N.48°E., 16 lks., with healed double blaze. (Record, 14 lks.) *NO BLZ. EVIDENCE*

*26" x 10 FT TALL SHATTERED STUMP* A hemlock *17" dia.* bears N.61°E., 5 lks. with healed blaze *FHSB*

*22" x 19" dia.* A hemlock *19" dia.* bears N.20 3/4° W., 35 lks., with healed blaze. *FHSB*

At the corner point

Set a stainless steel post, 28" long, 2 1/2" dia., 23" in the ground, directly over the 1 1/2" dia. iron pipe, with brass cap mkd.

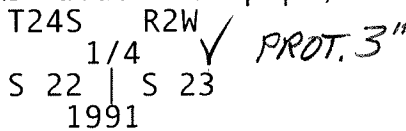

Deposit a white "DEEP-1" magnetic marker at base of stainless steel post.

NEW REFERENCES: A 1 1/4" DIA. HEMLOCK SCRIBED "1/4 S 22 BT" ON A SINGLE BLAZE  
ALSO A 3 1/2" MAG NAIL R.S.C. BEARS S 20° W, 5 3/4 FT DIST.

A 26" x 3 FT TALL HEMLOCK STUMP WITH A 3 1/2" MAG NAIL SET TOP CNTR. BEARS S 77° W 17 1/2 FT. DIST.

MONUMENT IS ON MODERATELY STEEP ENE SLOPE ON WEST EDGE OF OLD GROWTH LARGE CLEARCUT TO WEST.

MONUMENT IS APPROX 220 FT EAST FROM LOGGING SPUR ROAD.

CS 67102-12 pg 3/3