

GOVERNMENT CORNER RESTORATION FORM

FILED

TOWNSHIP 26S RANGE 1W SEC. 14 PLSS # 340406

Date: 3/2/20 By: KC
This survey consists of:

DOUGLAS COUNTY OREGON

DATE 2-25-26

Map: _____
Narrative: _____
Corner Rpt: CS67/02-17

DOUGLAS COUNTY
SURVEYOR

Corner Designation

1/4 COR 14/21

Monument(s) Found: (Condition and Source)

2 1/2" DCSO BRASS CAP
ON 1" IRON PIPE PROJ.
2"

- Condition report
- Not Found
- Renewed
- Unrecorded
- Surveyed In

Previous Renewals

GAYLARD U.S.F.S 1978 CS 59/46-7

MONUMENT DETAIL

DOUGLAS COUNTY
T26S R1W
1/2 516
1/4 521
1978

Accessories Found

SURVEYORS OFFICE

BURNED - DEAD 37" D. FIR N18P30'W 15.2 FT
HEATED BLAZE ADD 3 1/2" MAG NAIL RIGHT
SIDE CENTER

D. FIR STUMP 540°E 29.7 FT ROOTS AND
BARK REMAIN

3" X 2 1/2" STUB DOWN AND ROTTED 574°30'W
13.5 FT FOUND SCRIBING CS BT

12" D. FIR N57°E 29.2 FT FULLY HEATED
DOUBLE BLAZE

New Accessories

BURNED-DEAD 33" D. FIR N65°E 30.4 FT
ADD 3 1/2" MAG NAIL RIGHT SIDE CENTER

BURNED DEAD 6" R. CEDAR N22°W 12.5 FT
ADD 3 1/2" MAG NAIL RIGHT SIDE CENTER

Sketch of Monument, Accessories, and General Area


Location & Comments

MONUMENT ON SMALL FLAT BEACH
NEAR TOP OF S.W. RUNNING DRAW
N.E. QUADRANT IS BURNED OLD
GROWTH REST IS OLDER REPROD
MON IS APPROX 700 FT WEST
OF GRAVELED FOREST ROAD
TRIMBLE GEO XT POSITION

AREA BURNED
9/2020
Comp. Decline. 14 1/4° E
Agency DCSO
Party Chief S. F. HAUSE
Note keeper
Witnesses J. LORSUNG

43° 29904178 N
122° 82531381 W

CS 67162-17 pg 2/3

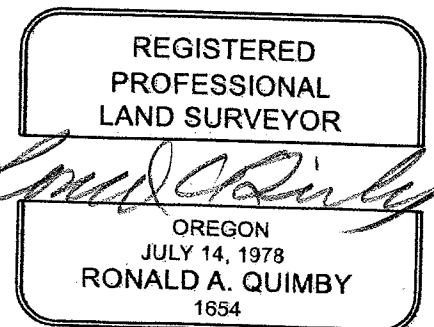

EXPIRES: 12/31/2026

WRIGHT CAK
FIRST FLAT

TOWNSHIP 26 RANGE 01 POINT IDENTIFIER # 340400

PRIMARY CORNER DESCRIPTION 1/4 Cor. Secs. 16 & 21

Alias _____	Description _____
Alias _____	Description <u>TRIMBLE GEO XT POSITION</u>
Alias _____	Description _____
Alias _____	Description <u>43.29904178°N</u> <u>122.82531381°W</u>

GLO survey by Fred Mensch, Deputy Surveyor - contract #797 dated April 19, 1910 - (DCSO records Vol. 10 Page(s) 4142)

Set a conglomerate stone 18x12x6", 12" in the ground for 1/4 sec. cor. mkd. 1/4 on N face, from which

A fir, 30" dia., bears N.78°W., 22 lks., mkd: 1/4 S16 BT.

A fir, 24" dia., bears S.40°E., 45 lks., mkd: 1/4 S21 BT.

DECLINATION 14'14"E

RENEWED 2/25/26

Dennis Gaylord, USFS & Deputy Co. Surveyor - Witness: Roland Simshauser - Jan. 26, 1978 - C.S. File 59/46-7

Found - Orig. corner stone is set solidly in place. Stone, 16x12x6", is mk. "X" on top and "1/4" on north face
30" now 37" D. Fir bears N.81°30'W, (Rec. N.78°W.)
15.2 ft (Rec. 14.52 ft.) Has a healed blaze. This tree is nearly dead. ADD 3 1/2" MAG NAIL R.S.C.

BURNED DEAD 37" →

BURNED TO GROUND ONLY BARK AND ROOTS

A 29" D. Fir stump bears S.40°E., 29.7 ft. to the face. Reverse scribing visible "S21 BT".

Set - Moving orig. stone monument aside, I set in its place a 2 1/2" brass cap on a 1" G.I. pipe. Cap stamped County Surveyors Office T26S R1W 1/4 S16 S21 1978. I bury the cor. stone alongside

New BTs - A 14" D. Fir bears S.74°30'W., 13.5 ft. scribed "1/4 S21 on a double blaze. FOUND CS BT NO DECENT ROOT HOLE

A 9" D. Fir bears N.57°E, 29.2 ft. scribed "1/4 S16 CS BT" on a double blaze. FHDB TO ROOT HOLE

Corner lies on south edge of clearcut unit.

NEW REFERENCES:

A BURNED DEAD 33" D. FIR WITH A 3 1/2" MAG NAIL SET R.S.C.; BEARS N65°E, 30 1/4 FT. DISTANT.

A BURNED DEAD 6" R. CEDAR WITH A 3 1/2" MAG NAIL SET R.S.C.; BEARS N22°W, 12 1/2 FT. DISTANT.

THE MONUMENT IS ON A SMALL FLAT BENCH NEAR THE TOP OF A SW RUNNING DRAW, THE NE QUADRANT IS A BURNED OLD GROWTH FOREST, REST OF AREA IS OLDER REPROD.

THE MONUMENT IS APPROX. 700 FT. WEST FROM A GRAVELLED FOREST ROAD.

CS 67162-17 pg 3/3