

GOVERNMENT CORNER RESTORATION FORM

FILED

TOWNSHIP 26S RANGE 1E SEC. 5 PLSS # 200700

Date: 3/17/20 By: KL  
This survey consists of:

DOUGLAS COUNTY OREGON

DATE 3-26-26

Map: \_\_\_\_\_

Corner Designation

SEC COR

T25S R1E

31/32

5/6

T26S

Narrative: \_\_\_\_\_  
Corner Rpt: CS 67162-18

DOUGLAS COUNTY  
SURVEYOR

Monument(s) Found: (Condition and Source)

3 1/4" GLD BRASS CAP

Proj 6"

\_\_\_ Condition report

\_\_\_ Not Found

Renewed

\_\_\_ Unrecorded

\_\_\_ Surveyed In

Previous Renewals

GLD 1928 V22 pg 9547-8

ODOT 2007 ST. HWY 138-0114

MONUMENT DETAIL

T25 1/2 S R1E

531/532

56/55

T26S

1928

Accessories Found

31" G. FIRE 559°W 16.5 FT (REC 549°W)

Fully Heated Single BLAZE

6" X 1/2 FT Rotted Cedar Stub N12°W

17.2 FT

N6S Monument Steam 582 3/4°W 416.9 FT

3 1/2" BRASS CAP under metal cover

8" Below parking lot surface

New Accessories

21" GRAND FIR S 110° E 17.8 FT 3 1/2"  
MAG Nail RIGHT SIDE CENTER

44" Red Cedar N 110° W 93.0 FT 3 1/2"  
MAG Nail RIGHT SIDE CENTER

Sketch of Monument, Accessories, and General Area

Location & Comments


MONI IS ON FLAT Flood  
PLAIN Bench approx 40 FT  
South of Paved Access  
ROAD

Trimble GED XT Position  
43° 20' 36" 79177 N.  
122° 44' 13" 64486 E.

Comp. Decline. 14 1/4° E  
Agency DCSO  
Party Chief S. F. House  
Note keeper  
Witnesses J. Korsun

CS 67/62-18

pg 2/3

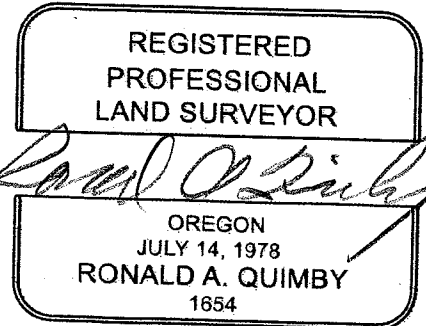

EXPIRES: 12/31/2026

PRIMARY CORNER DESCRIPTION Cor. Secs. 5, 6; 31 & 32 T25½-1E

Alias \_\_\_\_\_ Description \_\_\_\_\_  
 Alias \_\_\_\_\_ Description \_\_\_\_\_  
 Alias \_\_\_\_\_ Description \_\_\_\_\_  
 Alias \_\_\_\_\_ Description 43° 20' 36.79177"

DECLINATION 14' 14" E 122° 44' 13.64486"

RENEWED 2/26/26

GLO survey by Otto L. Draper, US Transitman, under Special Instructions dated Dec. 24, 1920 - (DCSO records Vol. 22 Page(s) 9547-8)

Set an iron post, 3 ft. long, 2" dia., 27" in the ground, for cor. of secs. 5, 6, 31, & 32, with brass cap mkd

3 1/4" B.C. T25½S R1E ✓  
 S 31 | S 32 PROT. 6"  
 S 6 | S 5  
 T26S  
 1928

from which:

GONE FALLS IN EXCAVATION

A fir, 30" dia., bears N. 12° E., 188 lks., mkd: T25½S R1E S32 BT. <sup>124<sup>08</sup></sup>

GONE NO EVIDENCE

A fir, 16" dia., bears S. 70° E., 33 lks., mkd: T26S R1E S5 BT. <sup>21<sup>78</sup></sup>

31" - AG fir, 8" dia., bears S. <sup>59°</sup> 45° W., 25 lks., mkd: T26S R1E S6 BT. <sup>16<sup>50</sup> ✓</sup> <sup>FHS13</sup>

ROTTEN 6" x 1/2 FT. STUB

A cedar, <sup>17<sup>16</sup> ✓</sup> 12" dia., bears N. 12° W., 26 lks., mkd: T25½S R1E S31 BT.

FD. by ODOT 10/2007, St. Hwy 138-011Y

FOUND

NGS MONUMENT STATION S82 3/4° W, 4169  
 A 3 1/2" B.C SET UNDER METAL COVER 8" BELOW PARKING LOT SURFACE

NEW REF'S:

21" G. FIR WITH A 3 1/2" MAG NAIL SET R.S.C. BEARS S11° E, 178 FT. DISTANT

44" R. CEDAR WITH A 3 1/2" MAG NAIL SET R.S.C. BEARS N11° W, 93 FT. DISTANT

MONUMENT IS ON FLAT FLOOD PLAIN BENCH AND APPROX. 40 FT. SOUTH FROM PAVED ACCESS RD.