

TOWNSHIP 32S RANGE 8W SEC. 3

PLSS # 900600

Date: 3/17/26 By: VC
This survey consists of:

DOUGLAS COUNTY OREGON

DATE 3-4-26

Map: _____
Narrative: _____
Corner Rpt: CS 07/02-19

Corner Designation

DOUGLAS COUNTY
SURVEYOR

Monument(s) Found: (Condition and Source)

3 1/4" BLM BRASS CAP
PROJ 5"

- Condition report
- Not Found
- Renewed
- Unrecorded
- Surveyed In

Previous Renewals

DCSD 1968 CS 54/45-8
AND CS 54/45-11 1970
BLM 1973-1975 Vol 90 pg 15991
Quimby 2002 - M 139-64 AEB
BLM 2002 Vol 54 pg 21095
Smalley 2003 M 143-2
DCSD GIS 1-2004 Typed 2/2011
Accessories Found CS 67/33-1

MONUMENT DETAIL

T32S R8W
54/53
59/510
 1975

53" P. Pine S23°E 18.5 FT (Rec S20°E 17.4 FT)
N/O MARKS ON OPEN BLAZE
Very Rotted 30" X 1 1/2 FT PINE STUMP S56°W
43.6 FT
36" D. FIR N153°E 17.8 FT Healed BLAZE
20" D. FIR S58 1/2°E 35.0 FT (Rec 35.6 FT)
27" D. FIR S61°W 12.5 FT Healed BLAZE
30" D. FIR N12 1/2°W 18.0 FT (Rec 18.5 FT)
Healed BLAZE

A GALV. POST EAST 1.8 FT

ADD 3 1/2" MAG NAIL RIGHT SIDE
CENTER TO LIVE BTS

Monument Set (Procedure and Description)

MONUMENT DETAIL

New Accessories

Sketch of Monument, Accessories, and General Area

Location & Comments

MON on moderate SW slope
S.E. DUNDRAUT is older
CLEAR CUT Rest is old THINWOOD
FOREST

MON is 75 FT
NORTH OF
GRAVEL ROAD


Trimble GEO XT POSITION
42° 2109 2025 N
123° 6418 4324 W

Comp. Decline 14'14"E
Agency DCSO
Party Chief SIFHAUSE
Note keeper
Witnesses J. LORSON

CS 67162-19

pg 2/4

REGISTERED
PROFESSIONAL
LAND SURVEYOR

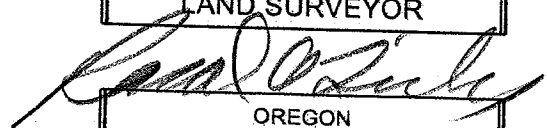

OREGON
JULY 14, 1978
RONALD A. QUIMBY
1654

EXPIRES: 12/31/2026

TOWNSHIP 32 RANGE 08 POINT IDENTIFIER # 400600

PRIMARY CORNER DESCRIPTION Cor. Secs. 3, 4, 9 & 10

Alias _____ Description _____
 Alias _____ Description _____
 Alias _____ Description _____
 Alias _____ Description _____

GLO survey by Richmond S. Dickerson, Deputy Surveyor under contract #474, dated May 10, 1883 - (DCSO records Vol. 21 Page(s) 8810)

Set a stone 14x10x8", 10" in the ground marked with five notches on the S & # notches on the E for the cor. to secs. 3, 4, 9, & 10, from which

A pine, 30" dia., bears N.11°E., 635 lks., mkd: T32S R8W S3 BT.

A pine, 36" dia., bears S.20°E., 24 lks., mkd: T32S R8W S10 BT.

A pine, 40" dia. bears S.56°W. 66 lks. mkd: T32S R8W S9 BT

A pine, 48" dia., bears N.79°W., 208 lks., mkd: T32S R8W S4 BT.

Douglas Co. Surveyors Office - John M. Powell - 3/26/1968 - C.S. File 54/65-8 & C.S. File 54/65-11 3/27/1970

Reported as not found.

Found - 3 pines, 1 live, 1 down, 1 burnt stump

Fit bearing & distances.

Cut very large opening in live tree. Nothing

Tore down tree completely apart (Nothing)

These are probably BTs but were probably bark scribed.

BLM dependent resurvey by Lynn M. Roseberry and Rollin D. Aanrud, Cadastral Surveyors, Group #821 & 876, surveyed July 1973/July 1975 - (DCSO records Vol. 40 Page(s) 15991)

The cor. of secs. 3, 4, 9, & 10, determined at record bearing and distance from the remains of the original BTs:

A ponderosa pine, 39" dia., bears S.20°E., 24 lks., no marks visible on opened blaze.

A decayed ponderosa pine stump, bears S.56°W., 66 lks., no mark visible.

A decayed ponderosa pine stump, size indeterminate, bears N.79°W., 208 lks., no marks visible.

At the corner point

Set an iron post, 28" long, 2½" dia., 22" in the ground, with brass cap mkd.

T32S	R8W
S 4	S 3
S 9	S 10
1975	

from which

A fir, 23" dia. bears N.55°E., 27 lks. mkd: T32S R8W S3 BT

A fir, 12" dia., bears S.58½°E., 54 lks., mkd: T32S R8W S10 BT.

continued next page

MINI GUS
42.81104
123.54186

TOWNSHIP 32 RANGE 08 POINT IDENTIFIER # 400600

PRIMARY CORNER DESCRIPTION Cor. Secs. 3, 4, 9 & 10

Alias _____	Description _____
Alias _____	Description <u>TRIMBLE GEO XT POSITION</u>
Alias _____	Description _____
Alias _____	Description <u>42.81092025° N</u>
	<u>123.64184324° W</u>

A fir, 15" dia. bears S.61°W., 19 lks. mkd: T32S R8W S9 BT
 A fir, 18" dia. bears N.12½°W. 28 lks. mkd: T32S R8W S4 BT
DECLINATION 14°14'E RENEWED 3/4/26
 Fd. Ok by R. Quimby, 3/2002 - M139-64 A&B

BLM dependent resurvey by Terrence O. Nickerson, Cadastral Surveyor under Group #2004, survey March/Oct. 2002 - (DCSO records Vol. 54 Page(s) 21095)

The cor. of secs. 3, 4, 9, & 10, monumented with an iron post, 2½" dia., firmly set, projecting 4" above the ground, with brass cap (properly) mkd.

from which the remains of the original bearing trees
53" A ponderosa pine 52" dia., bears S.20° E., 17.4 ft., with no marks visible on open blaze. 23° (Record, 15.8 ft.)

*VERY ROTTEN ~ 30" x 1½"
 NOT LOOKED FOR - TOO MUCH ON LINE*

A decayed pine stump, size indeterminate, bears S.56° W., 43.6 ft., no marks.

A root hole, bears N.79°W., 137.3 ft.

and bearing trees mkd. by Roseberry and Aanrud

36" AD. fir, 31" dia., bears N.55°E., 17.8 ft., with healed blaze. ✓

20" AD. fir, 14" dia., bears S.58½°E., 35.0 ft., with healed blaze. ✓

27" AD. fir, 22" dia., bears S.61°W., 12.5 ft., with healed blaze. ✓

30" AD. fir, 24" dia., bears N.12½°W., 18.0 ft., with healed blaze. ✓

FOUND A GALV. STEEL LATH EAST, 18 FT. ADD 3½" MAGNAIL R.S.C. TO ALL FOUND LIVE B.T.S
 Fd. Ok by M. Smalley, 4/2003 - M143-2

DCSO-GIS Corner visitation - 1/29/2004 - Typed: 2/10/2011 - C.S. File 67/33-1

Monument - 2½" IP/BC Comment - ok

MONUMENT IS ON MODERATE SW SLOPE, SE QUADRANT IS OLDER CLEARCUT, REST IS OLD THINNED FOREST. MONUMENT IS 75 FT. NORTH FROM A GRAVEL ROAD.

CS 67162-19 pg 4/4