

GOVERNMENT CORNER RESTORATION FORM

FILED

TOWNSHIP 245 RANGE 8W SEC. 14 PLSS # 500440

Date: 3/19/20 By: lc  
This survey consists of:

DOUGLAS COUNTY OREGON DATE 3-17-20

Map: \_\_\_\_\_  
Narrative: \_\_\_\_\_  
Corner Rpt: CS 67/62-24

Corner Designation 1/4 COR S15/S14

DOUGLAS COUNTY SURVEYOR

Monument(s) Found: (Condition and Source)  
2 1/2" DC SO BRASS CAP  
proj 12"

- Condition report
- Not Found
- Renewed
- Unrecorded
- Surveyed In

Previous Renewals  
DC SO 1963 CS 49/84-9

MONUMENT DETAIL  
COUNTY SURVEYORS  
OFFICE  
T245 RBW  
1/4 S15/S14  
1963

Accessories Found  
Very Rotted 25" x 1 FT SAWN FIR STUMP  
N 85° E 35.0 FT

20" D. FIR N 6° E 11.0 FT Fully Heated Double  
BLAZE

25" W. FIR S 49° W 15.0 FT Fully Heated  
Double BLAZE

Unrecorded ACCESSORIES  
14" D. FIR S 24° W 22.0 FT Fully Heated  
Single BLAZE

21" CHINQUAPIN N 55° E 31.0 FT AXE  
MARK IN BARK SMALL BLAZE Scriped BT  
ADD 3 1/2" MAG NAIL TO TREES RIGHT Side Center  
Steel posts 0.7 FT North  
2.0 FT South

C.S. File CS 67/62-24

---



---



New Accessories

---



---



Sketch of Monument, Accessories, and General Area

Location & Comments

MON ON Gentle South Slope  
 OLD Reprod To West Younger  
 Reprod To East

MON IS APPROX  
 210 FT SOUTH  
 OF GRAVEL ROAD


Trimble GED XT POSITION

43° 48 20 11 18 N  
 123° 6 29 2 78 6 2 N

Comp. Decline. 14 1/4° E  
 Agency DCSO  
 Party Chief S. F. HAUSE  
 Note keeper  
 Witnesses J. LORSUM

CS 67/62-24 pg 2/3

REGISTERED  
 PROFESSIONAL  
 LAND SURVEYOR

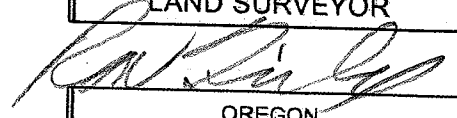

OREGON  
 JULY 14, 1978  
 RONALD A. QUIMBY  
 1654

EXPIRES: 12/31/2026

TOWNSHIP 24 RANGE 08 POINT IDENTIFIER # 500440

PRIMARY CORNER DESCRIPTION 1/4 Cor. for Secs. 14 and 15

Alias _____	Description _____
Alias _____	Description <u>TRIMBLE GEO XT POSITION</u>
Alias _____	Description _____
Alias _____	Description <u>43.48201118°N</u> <u>123.62427862°W</u>

GLO Survey by Henry L. Chandler, U.S. Deputy Surveyor, under Contract #619, dated June 5, 1893 - (DCSO records Vol. 8 Page(s) 3334)

Set a post 3½ ft. long, 3" sq., 24" in the ground, for ¼ sec. cor. marked ¼ S on W. face, from which  
A Fir 10" dia., bears N.85°E., 53 lks. dist. mkd. ¼ S BT  
A Chinquapin 10" dia., bears N.62°W., 23 lks. dist. mkd. ¼ S BT.

DECLINATION 14¼°E

RENEWED 3/17/26

Douglas Co. Surveyors Office - Milo E. Godfrey, Deputy - Mike Stone & Vernon "Ray" Tracy, crew - May 1963 - C.S. File 49/84-9

VERY ROTTED 25" x 1 FT. SAWN FIR STUMP

Found - 28" D. Fir tree, N.85°E., 35.0 ft. Cut open and found good scribing "S".

GONE Chinquapin, down but stump in place, N.62°W., 15.2 ft. Shows good scar on bark but center completely rotted away. No scribing found.

Set Brass cap at cor. mkd: County Surveyors Office

2 1/2" BC T 24 S R 8 W  
¼ S15 | S14  
1963  
PROT 12"

New BTs - 20" 9" D. Fir ✓ N.6°E., 11.0 ft ✓ mkd. ¼ S14 CS BT FHDB  
25" 10" W. Fir ✓ S.49°W., 15.0 ft ✓ mkd. ¼ S15 CS BT.  
Corner lies on nearly level bench land. FHDB

FOUND UNRECORDED ACCESSORIES STEEL LATH 02 FT NORTH  
" " 20 FT SOUTH

14" D. FIR WITH FULLY HEALED SINGLE BLZ. BEARS S24°W, 22° (TAG S28°W, 22°)

NEW REFERENCE:

21" CHINQUAPIN WITH AXEMARK IN BARK AND SMALL BEARS N55°E, 31° FT.  
BLZ. SCRIBED "BT"

MONUMENT IS ON GENTLE SOUTH SLOPE, OLD REPROD TO WEST YOUNGER REPROD TO EAST. MONUMENT IS APPROX 210 FT. SOUTH FROM GRAVEL ROAD.