

TOWNSHIP 26S RANGE 8W SEC. 11

PLSS # 540506

Date: 4/8/20 By ke  
This survey consists of:

DOUGLAS COUNTY OREGON

DATE 3-26-24

Map: \_\_\_\_\_

Narrative: \_\_\_\_\_  
Corner Rpt: CS 67/02-34

Corner Designation

1/4 COR 11/14

DOUGLAS COUNTY  
SURVEYOR

Monument(s) Found: (Condition and Source)

2 1/2" DCSO BRASS CAP  
proj 16"

- Condition report
- Not Found
- Renewed
- Unrecorded
- Surveyed In

Previous Renewals

DCSO 1968 CS 54/72-21

MONUMENT DETAIL

COUNTY SURVEYORS  
OFFICE

T 26S 8W

1/4 S11  
1/4 S14

1968

Accessories Found

SAWN 60" X 2 1/2 FT FIR STUMP N55°W  
35.5 FT (DIST NOT CHECKED)

SAWN Rotted 38" X 3 FT D FIR STUMP  
S38°E 9.6 FT FULLY HAZED SINGLE BLAZE

Very Rotted 30" X 2 1/2 FT Hemlock STUMP  
N81°E 7.0 FT FACE LOOSE FROM STUMP  
HAS ALL SCRIBING

New Accessories

10" D. FIR N11°W 16.2 FT Scribed  
 1/4 S 11 BT ON Double BLAZE 3 1/2"  
 MAG NAIL RIGHT Side Center

18" D FIR N140°W 11.3 FT Scribed  
 1/4 S 11 BT ON Double BLAZE 2 1/2"  
 MAG NAIL RIGHT Side Center

20" D. FIR S34°W 25.2 FT Scribed  
 1/4 S 14 BT ON Double BLAZE 3 1/2" MAG  
 NAIL RIGHT Side Center

Sketch of Monument, Accessories, and General Area

Location & Comments

New Gravel Road is EAST  
 85 FT AND Edge OF FIRE  
 Break is South 40 FT

Trimble GED XT Position


43° 3162 4974 N  
 123° 6146 0210 W

Comp. Decline. 14 1/2° E  
 Agency DC60  
 Party Chief S. F. Haase  
 Note keeper  
 Witnesses J. Lorusso

CS 67/62-34

pg 2/3

REGISTERED  
 PROFESSIONAL  
 LAND SURVEYOR

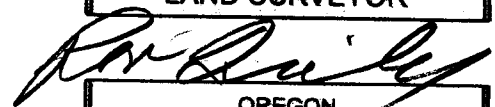

OREGON  
 JULY 14, 1978  
 RONALD A. QUIMBY  
 1854

EXPIRES: 12/31/2026

TOWNSHIP 26 RANGE 08 POINT IDENTIFIER # 540500

PRIMARY CORNER DESCRIPTION 1/4 Cor. Secs. 11 & 14

Alias	Description
Alias	Description <u>TRIMBLE GEO XT POSITION</u>
Alias	Description
Alias	Description <u>43.31624974°N</u> <u>123.61460210°W</u>

MINI GIS  
43.31611  
123.61465

GLO survey by William P. Heydon, Deputy Surveyor, under contract No. 656, dated May 21, 1896 - (DCSO records Vol. 11 Page(s) 4668)

Set fir post, 3 ft. long, 4" sq., 24" in the ground for 1/4 sec. cor. mkd 1/4 S on N face, from which  
A fir, 36" dia., bears N.55°W., 54 lks., mkd: 1/4 S BT.  
A hemlock, 8" dia., bears S.54°W., 33 lks., mkd: 1/4 S BT.

DECLINATION 14 1/4° E

RENEWED 3/26/26

Douglas Co. Surveyors Office - Vernon "Ray" Tracy - Jack Heritage - V. Perron - Sept. 1968 - C.S. File 54/72-21

SAWN 60" x 2 1/2" FT STUMP  
SOME ROTT

Found - Orig. 36", now ~~54"~~ 54" D. Fir, alive, N.55°W 35.6 ft. DIST NOT  
opened, blaze pitched over. FHSB CHK'D BRUSH ONLINE  
GONE - Orig. 8" Hemlock, now 16" shattered stump, ~~S.54°W.~~  
NO EVIDENCE 21.8 ft., find "1/4 S BT" scribe on pieces.

Set - Brass Cap at Cor. Mkd: County Surveyors T26S R8W 2 1/2" B.C.  
Office 1/4 S 11 PROT. 16"  
1968 S 14

SAWN ROTTED 38" x 3" STUMP  
VERY ROTTED 30" x 2 1/2" STUMP

New BTs - 36" D. Fir S.38°E, 9.6 ft. mkd: "1/4 S14 CS BT" FHSB  
24" Hemlock N.8°E, 7.0 ft. mkd: "1/4 S11 CS BT" FACE LOOSE FROM TREE  
This corner lies on moderate east slope 50 ft. W. of old logging road. - NEW GRAVEL RD IS EAST 85 FT. AND EDGE OF FIREBREAK IS SOUTH 40'  
NEW REF.

- 10" D. FIR SCRIBED "1/4 S11" BT ON A DOUBLE BLAZE; BEARS N11°W, 16 1/2 FT. DIST
- 18" D. FIR SCRIBED "1/4 S11" BT ON A DOUBLE BLAZE; BEARS N40°W, 11 1/2 FT. DIST.
- 20" D. FIR SCRIBED "1/4 S14" BT ON A DOUBLE BLAZE; BEARS S34°W, 25 1/2 FT. DIST.